


LEGEND

- Existing LPG Line
- Oxygen Line
- Electrical Duct: Fire Alarm and Access Control
- Spare Duct

Oxygen Main Manifold

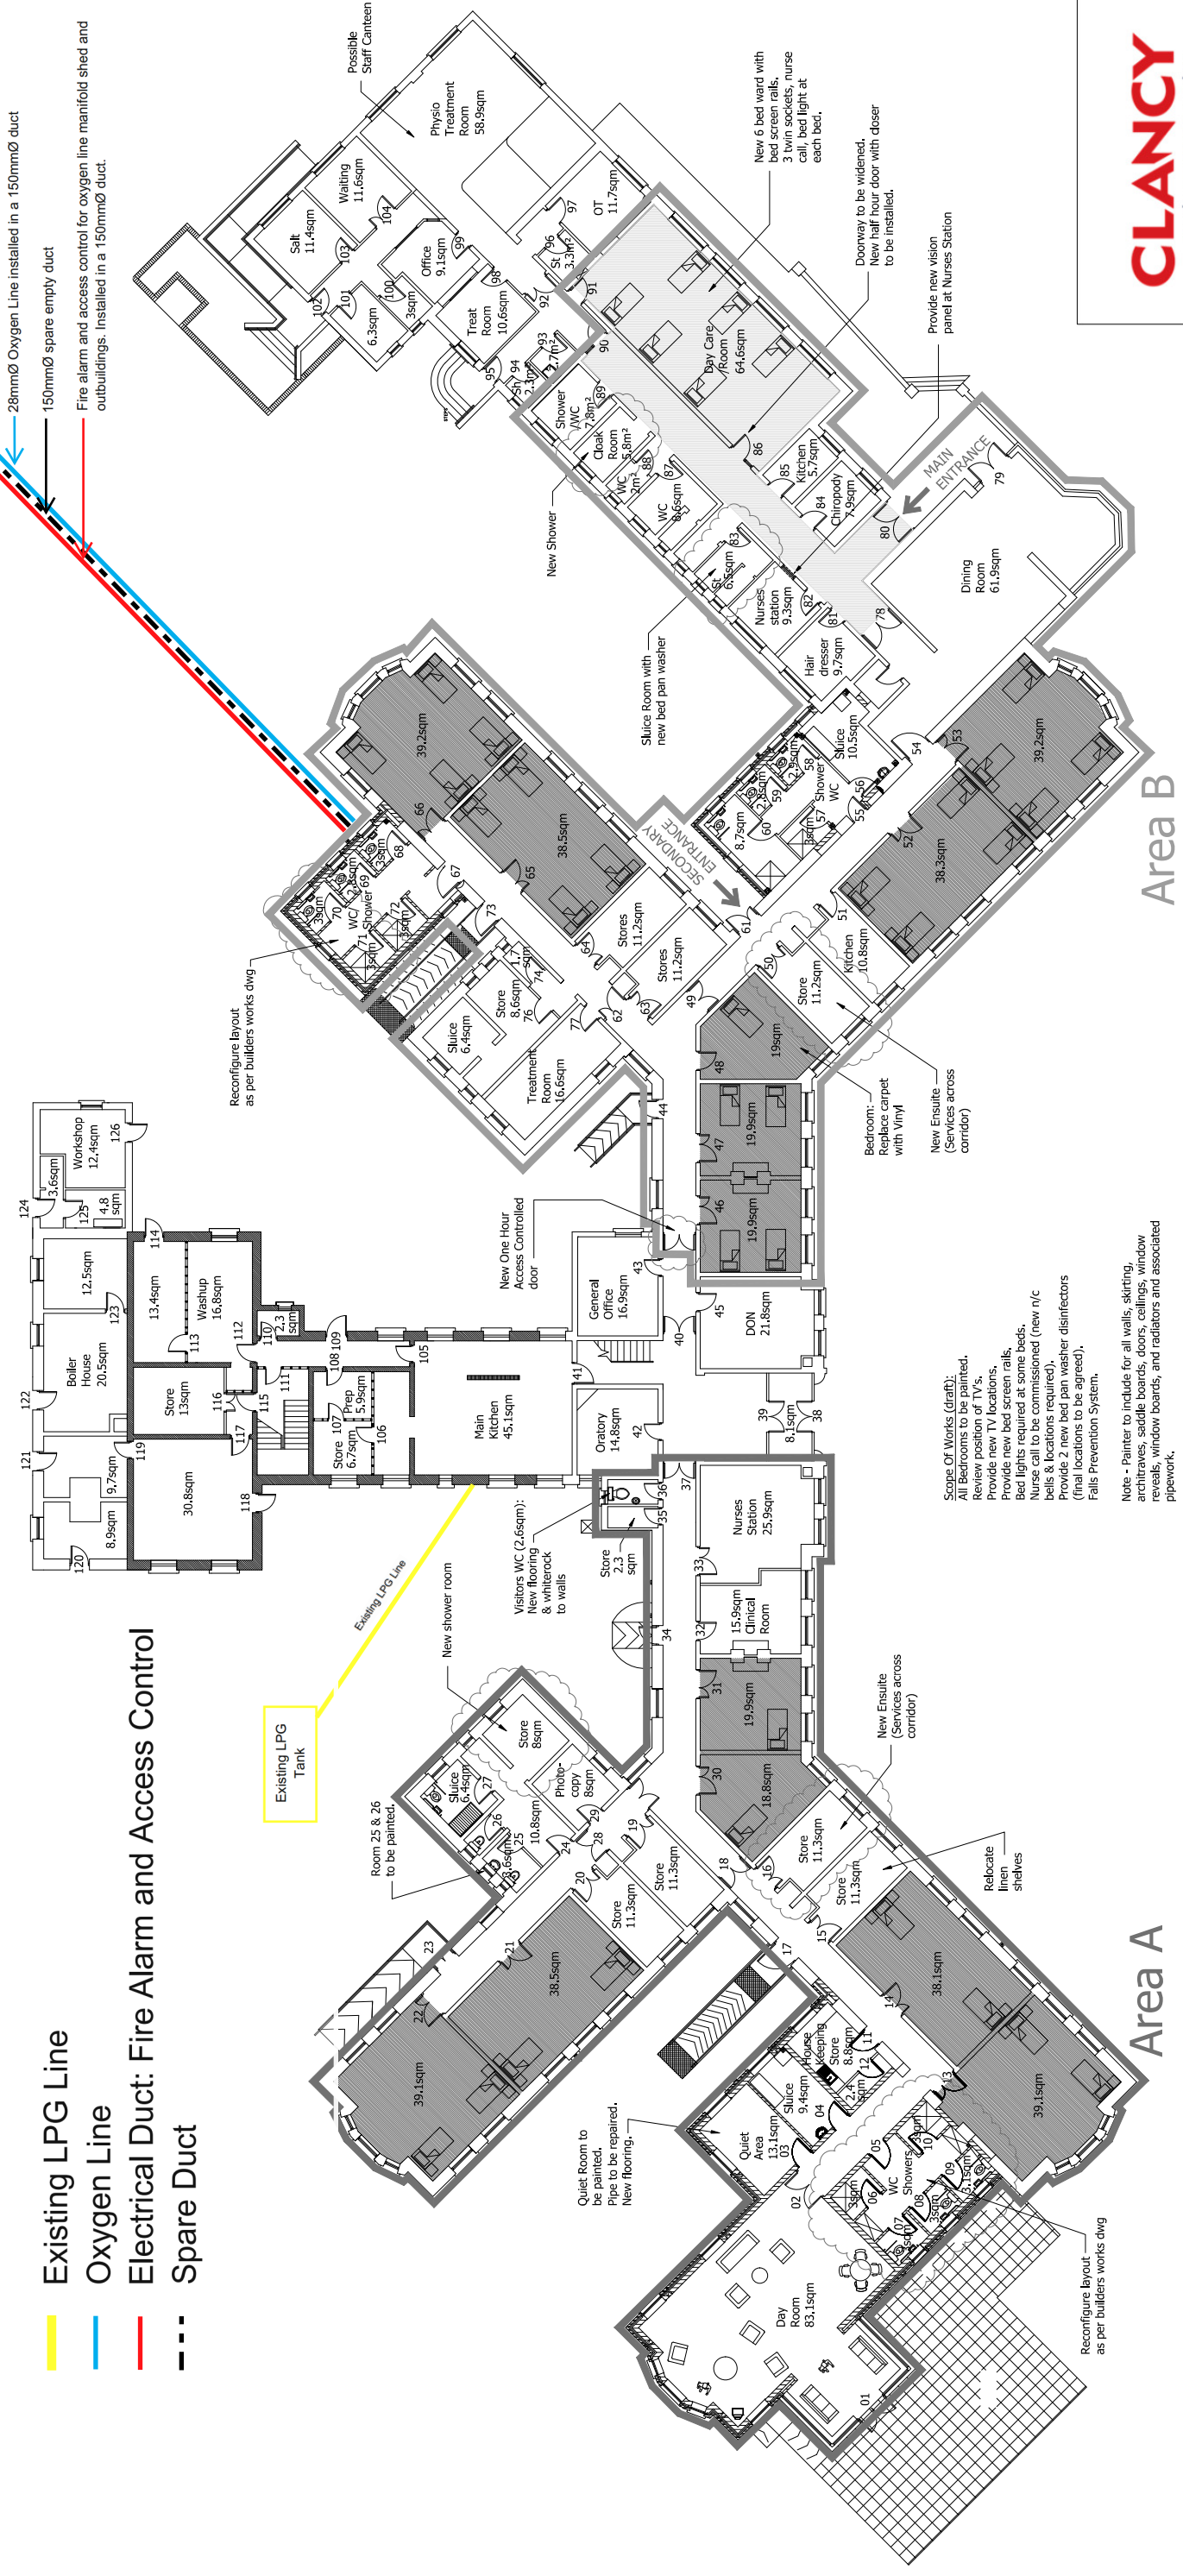

Area B

Area A

Scope Of Works (draft):
All Bedrooms to be painted.
Review position of TVs.
Provide new TV locations.
Provide new bed screen rails.
Bed lights required at some beds.
Nurse call to be commissioned (new n/c bells & locations required).
Provide 2 new bed pan washer disinfectors (final locations to be agreed).
Falls Prevention System.

Note - Painter to include for all walls, skirting, architraves, saddle boards, doors, ceilings, window reveals, window boards, and radiators and associated pipework.

CLANCY
Built on Partnership

Clancy, Drangan, Thurles,
Co. Tipperary, Ireland.
Tel: 052 91 52166 Fax: 052 91 52280
Email: build@clancy.ie

PROJECT	Abbeyleix Community Nursing Unit, Knocknamoe, Abbeyleix, Co. Laois		
TITLE	AS-BUILT GAS AND ELECTRICAL SERVICES LAYOUT		
SCALE	NTS	DWG NO: AB -02	REVISION
DATE	13.05.2020	DRAWN: LH	CHECKED: IM
			A

CNU Abbeyleix
Ground Floor