
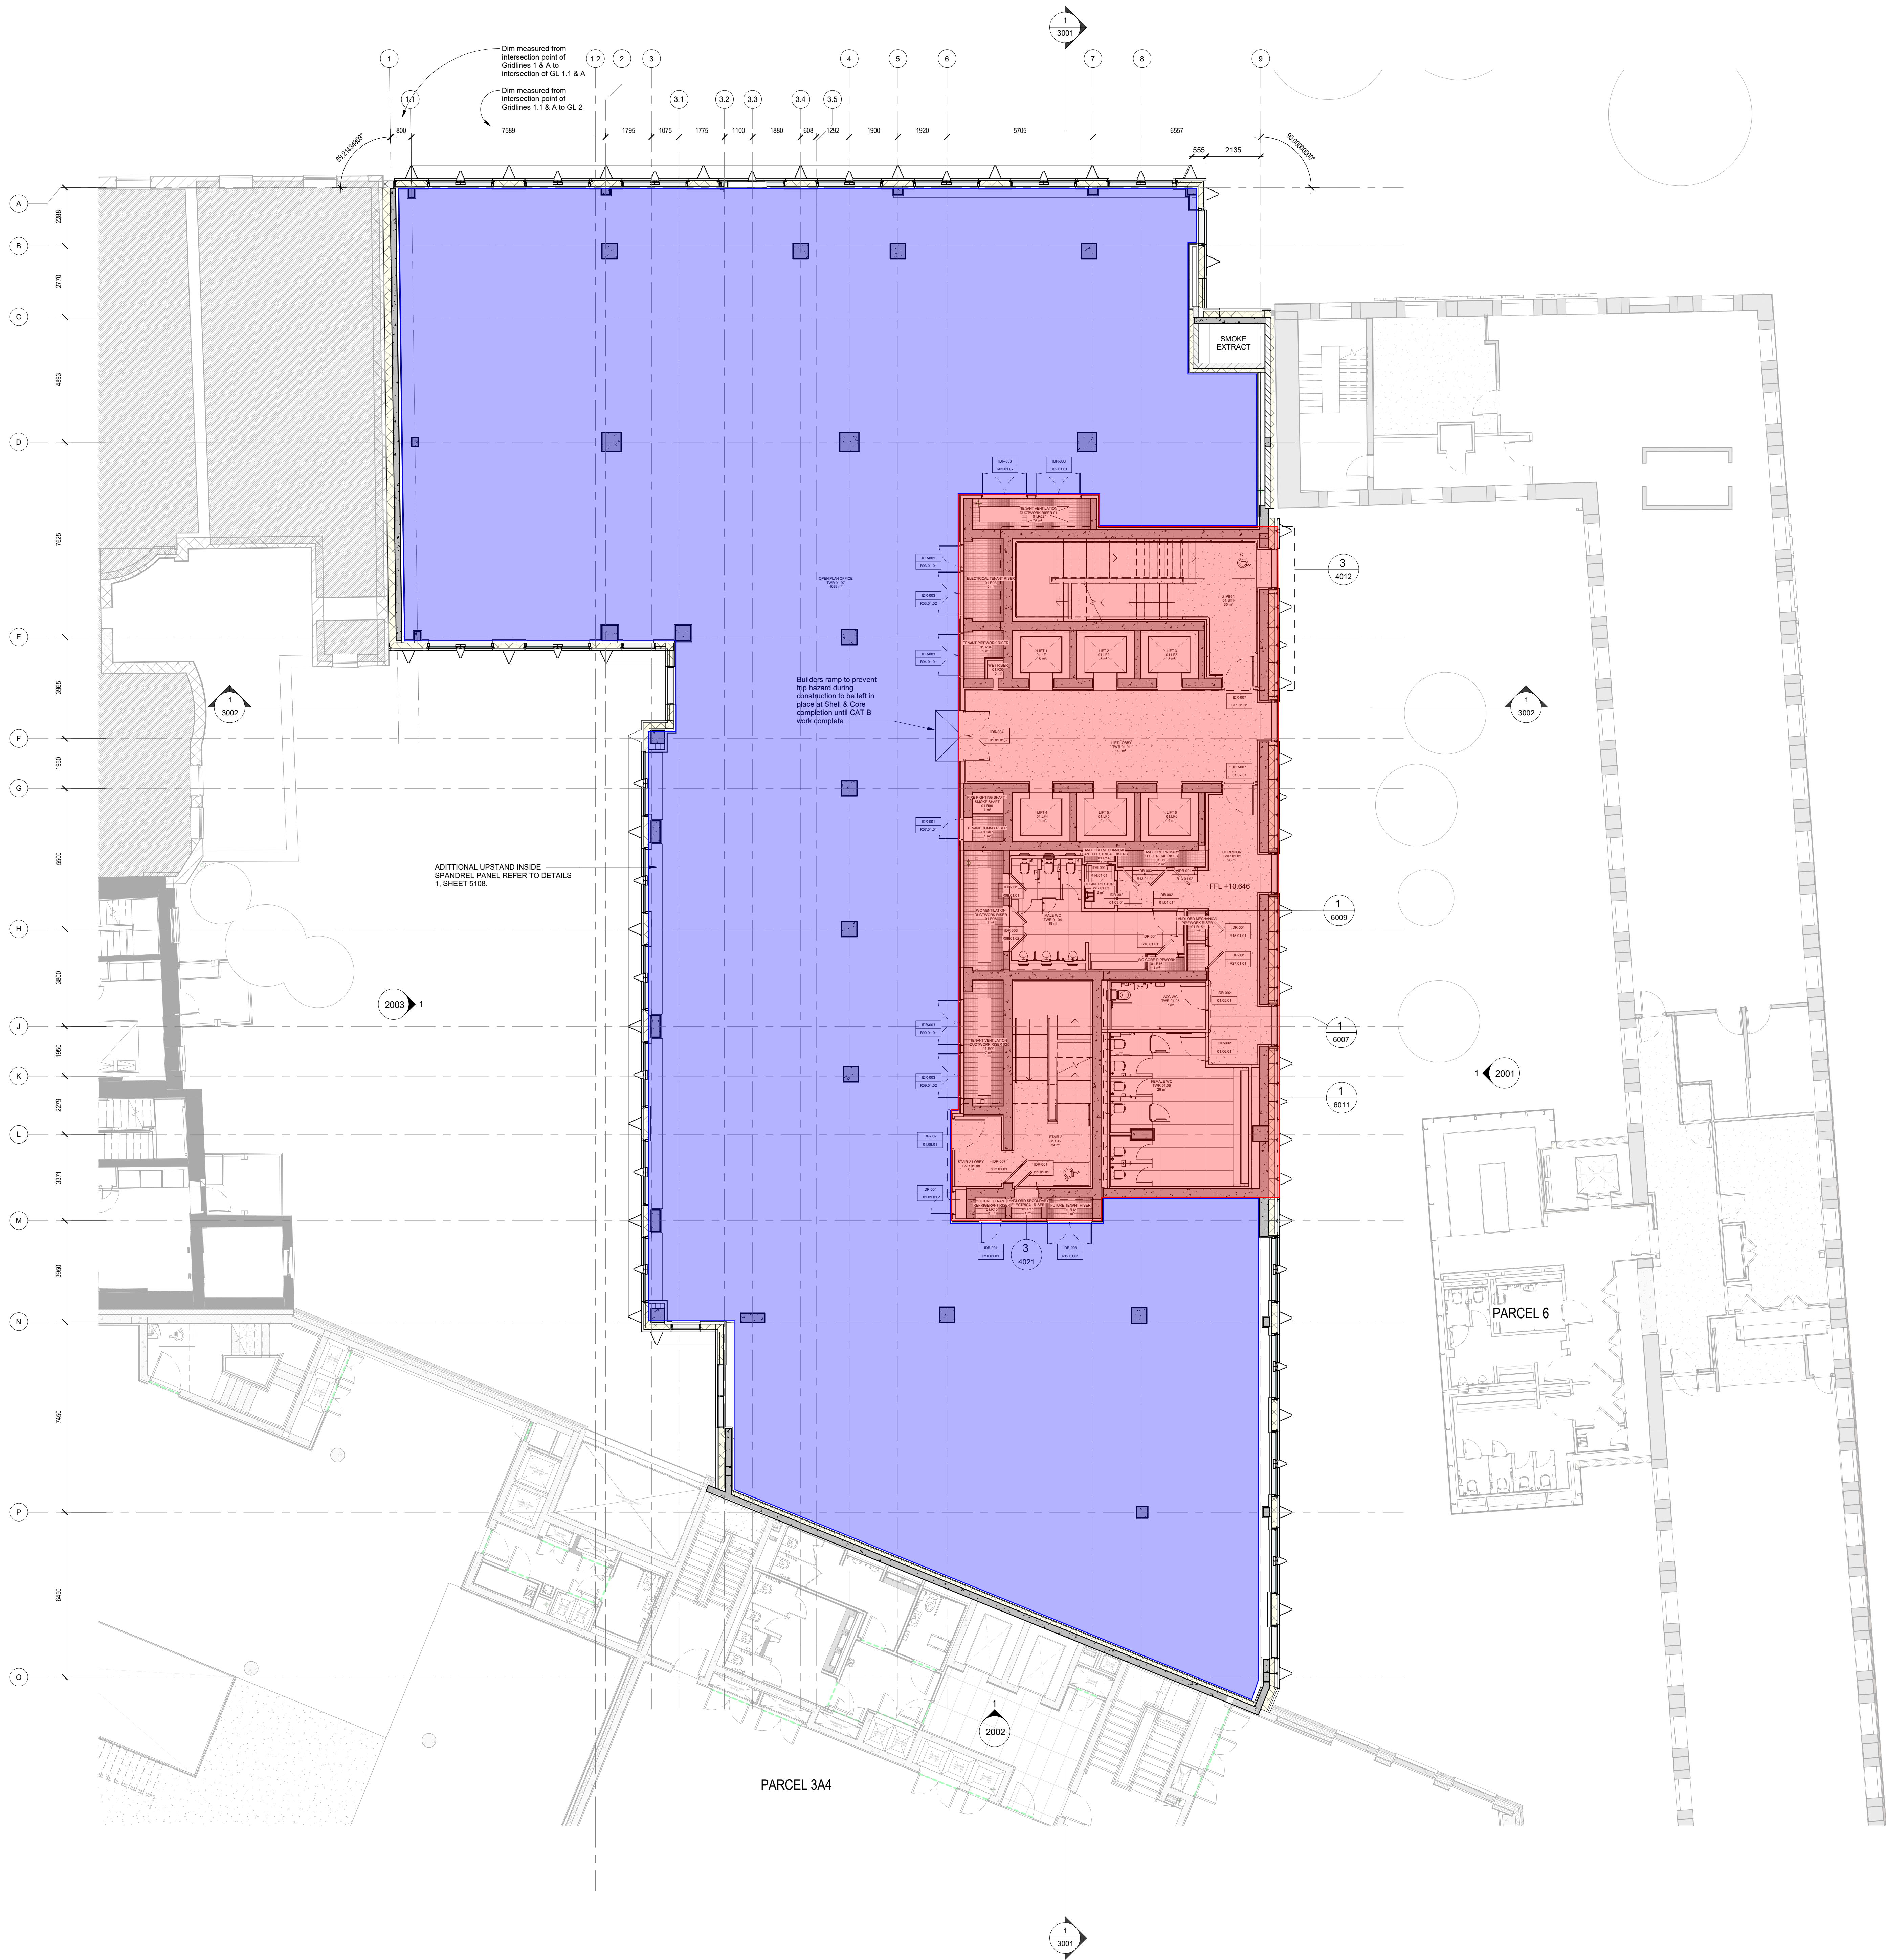


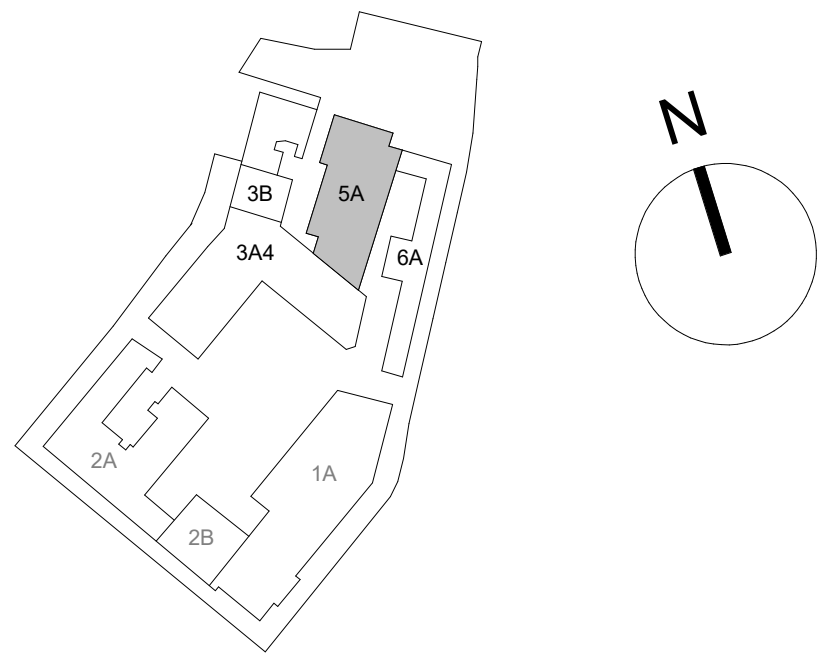

- GENERAL NOTES:
- TO BE READ IN CONJUNCTION WITH HJL WORKS REQUIREMENTS DOCUMENTS INCLUDING SPECIFICATIONS.

2026.06.05_OPW Markup

- Landlord areas to be fitted out as part of the Shell + Core works currently on site
- 'Grey box' office areas to be designed and constructed as part of this Fit Out project.

REV	DATE	DESCRIPTION	HJL	HJL
C01	October 2023	Issued for Tender	CHK	DRN

STATUS CODE DESCRIPTION:
ISSUED FOR TENDER

CLIENT:
Limerick 2030

PROJECT:
Project Opera Contract D

DRAWING:
GA_FIRST_FLOOR_PLAN

PROJECT NUMBER OPRA	DATE 12/07/2021
SCALE @ A0: As indicated	DRAWN/CHECKED: ROO/KMM
STATUS CODE: A4	DRAWING NUMBER OPRA-HJL-SA-01-DR-A-1011
REVISION C01	

Henry J Lyons

Architecture + Interiors
henryjlyons.com
+353 21 422 2002
info@henryjlyons.com
16 Leventy Quay
Cork T12 ED34

GA - 01 - FIRST FLOOR
1 : 100