


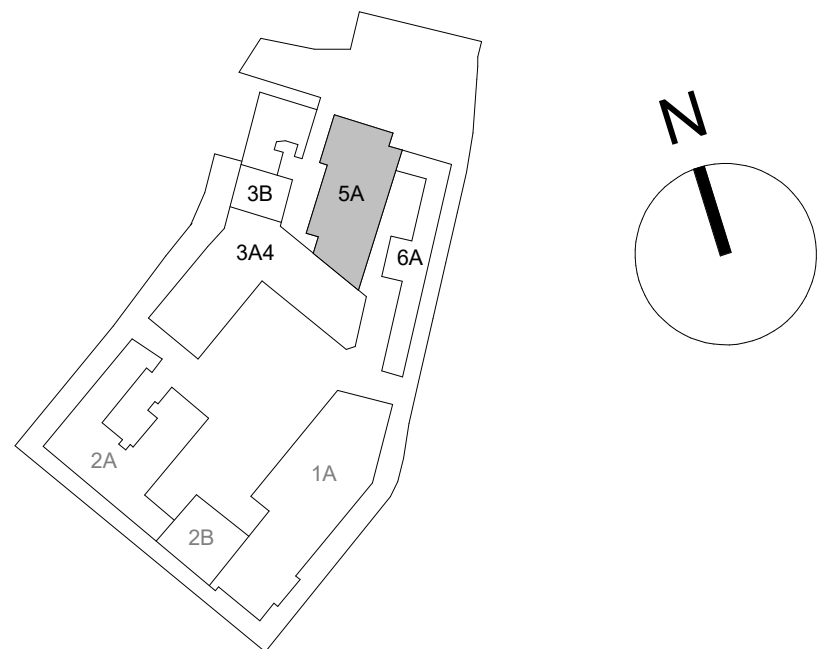

GENERAL NOTES:

1. TO BE READ IN CONJUNCTION WITH HJL WORKS REQUIREMENTS DOCUMENTS INCLUDING SPECIFICATIONS.

2026.06.05_OPW Markup

- Landlord areas to be fitted out as part of the Shell + Core works currently on site
- 'Grey box' office areas to be designed and constructed as part of this Fit Out project.

RAISED ACCESS FLOOR INSTALLED AS PART OF TENANT FIT-OUT

REV	DATE	DESCRIPTION	HJL	HJL
C01	October 2023	Issued for Tender		
REV	DATE	DESCRIPTION	CHK	DRN

STATUS CODE DESCRIPTION:
ISSUED FOR TENDER

CLIENT
Limerick 2030


PROJECT
Project Opera Contract D

DRAWING
GA - FIFTH SIXTH FLOOR PLAN

PROJECT NUMBER OPRA	DATE 17/05/22
SCALE @ A0: As indicated	DRAWN/CHECKED: JH KMM
STATUS CODE: A4	DRAWING NUMBER OPRA-HJL-5A-05-DR-A-1015
	REVISION C01

Henry J Lyons

Architecture + Interiors
henryjlyons.com
+353 21 422 2002
info@henryjlyons.com
16 Levens Quay
Cork T12 ED2H

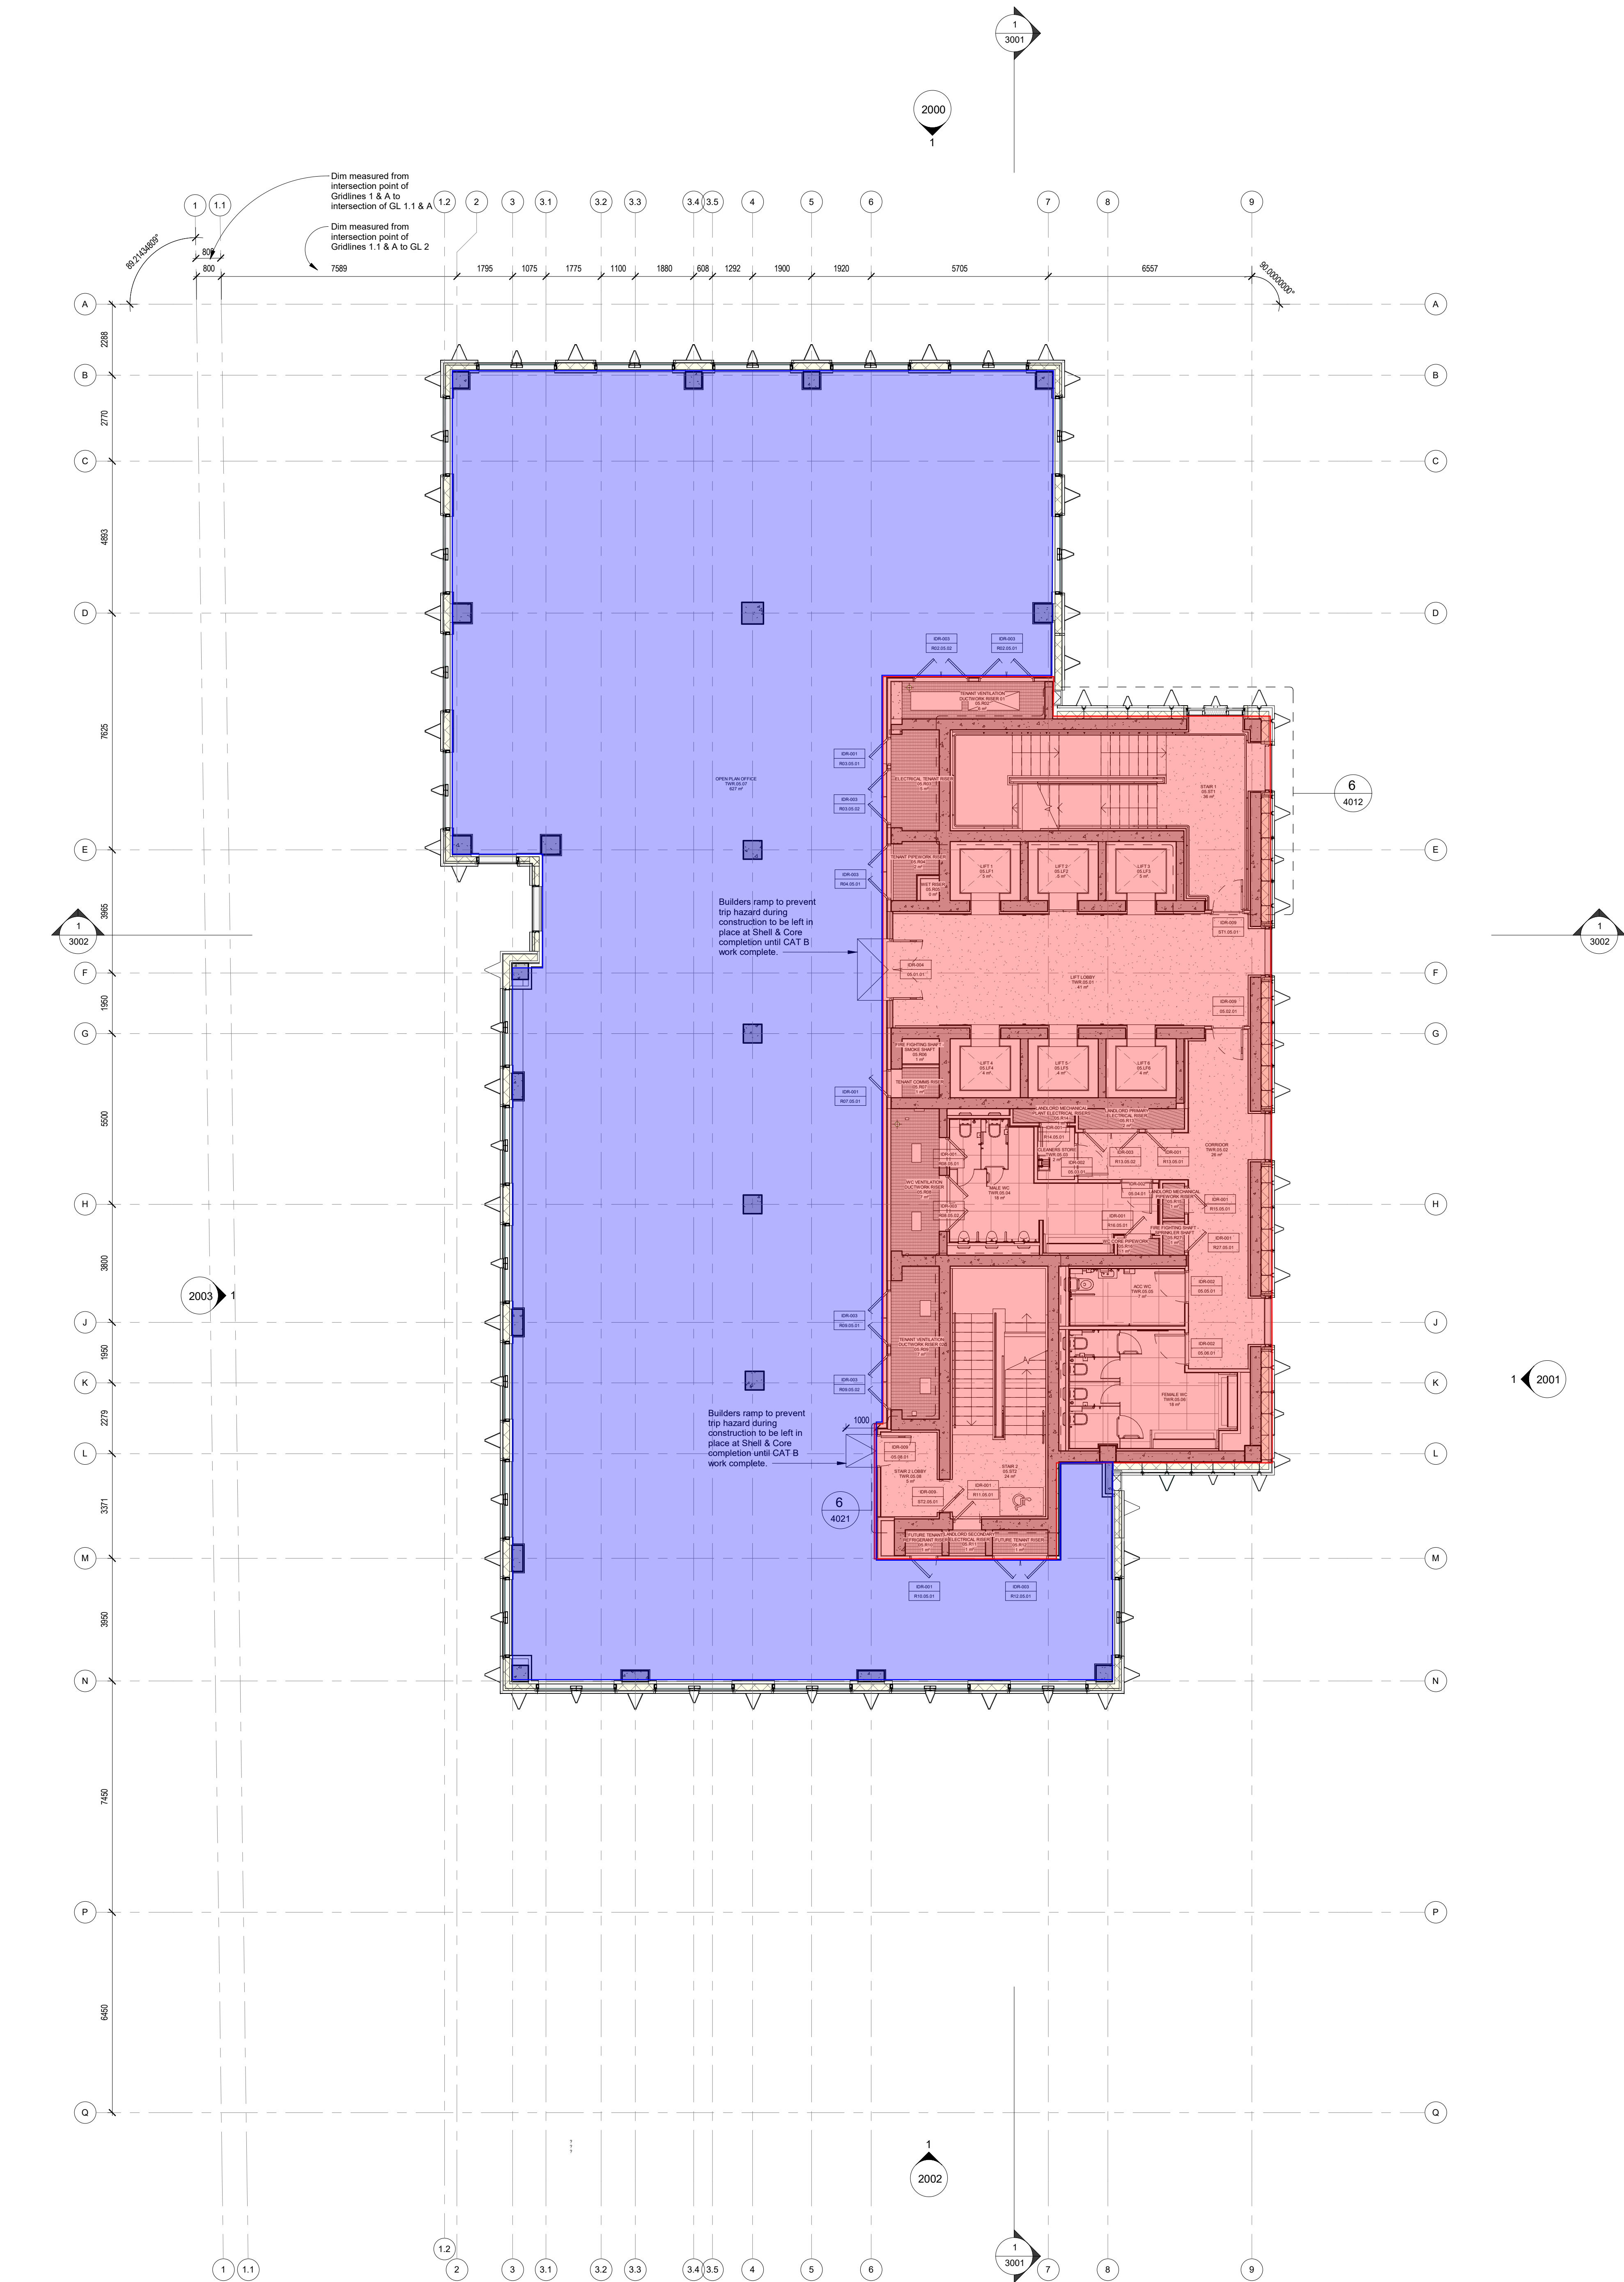

GA - 05-06 - FIFTH AND SIXTH FLOOR
1 : 100