




MANHOLE	COVER LEVEL (m)	INVERT LEVEL (m)	INVERT LEVEL (m)
F21	183.500	181.640	
F20	181.321	178.381	
F17	178.324	176.754	
F10	178.344	175.224	
F14	183.387	181.867	
F11	181.222	179.322	
FX	182.100	180.500	
S8	183.535	181.725	
S13	181.329	178.359	
S12	178.408	176.878	
S5	178.404	176.824	175.654
S7	183.389	181.869	
S6	181.861	180.271	

- LEGEND
- FOUL MANHOLE COVER
 - SURFACE MANHOLE COVER
 - WATER CONNECTION COVER
 - SLUICE VALVE
 - TELECOMS MANHOLE COVER
 - ESB MANHOLE COVER
 - ROAD GULLY COVER
 - FIRE HYDRANT COVER
 - STREET LIGHT
 - FOUL SEWER
 - SURFACE WATER SEWER
 - ESB SUPPLY
 - TELECOMS SUPPLY
 - MAINS WATER
 - Foul Sewer to be relaid
 - SW Sewer to be relaid
 - Extent of wearing course to be replaced
 - Footpath to be replaced

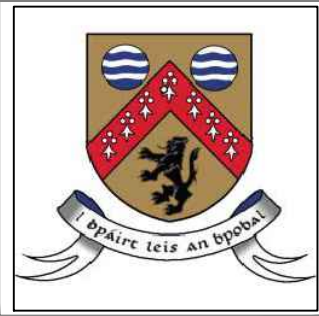

LAOIS COUNTY COUNCIL

ANGELA MCEVOY
DIRECTOR OF SERVICES
HOUSING, REGENERATION, AND PLANNING
DEVELOPMENT AND CONTROL

COUNTY HALL
PORTLAOISE,
PHONE (057) 8664000

Department

PLANNING DEPARTMENT

Title

CLARMALLAGH
Slatt Lower, The Swan, Co. Laois,

©Tailte Eireann Surveying.
All rights reserved.
CYAL50510770

Scale: 1:250@A1

Drawn: A. Hassan
Checked: J. O'SULLIVAN

DATE: 28/07/2026

DRAWING: 001

FILING NO.: TIC