


City Wall

Town Hall

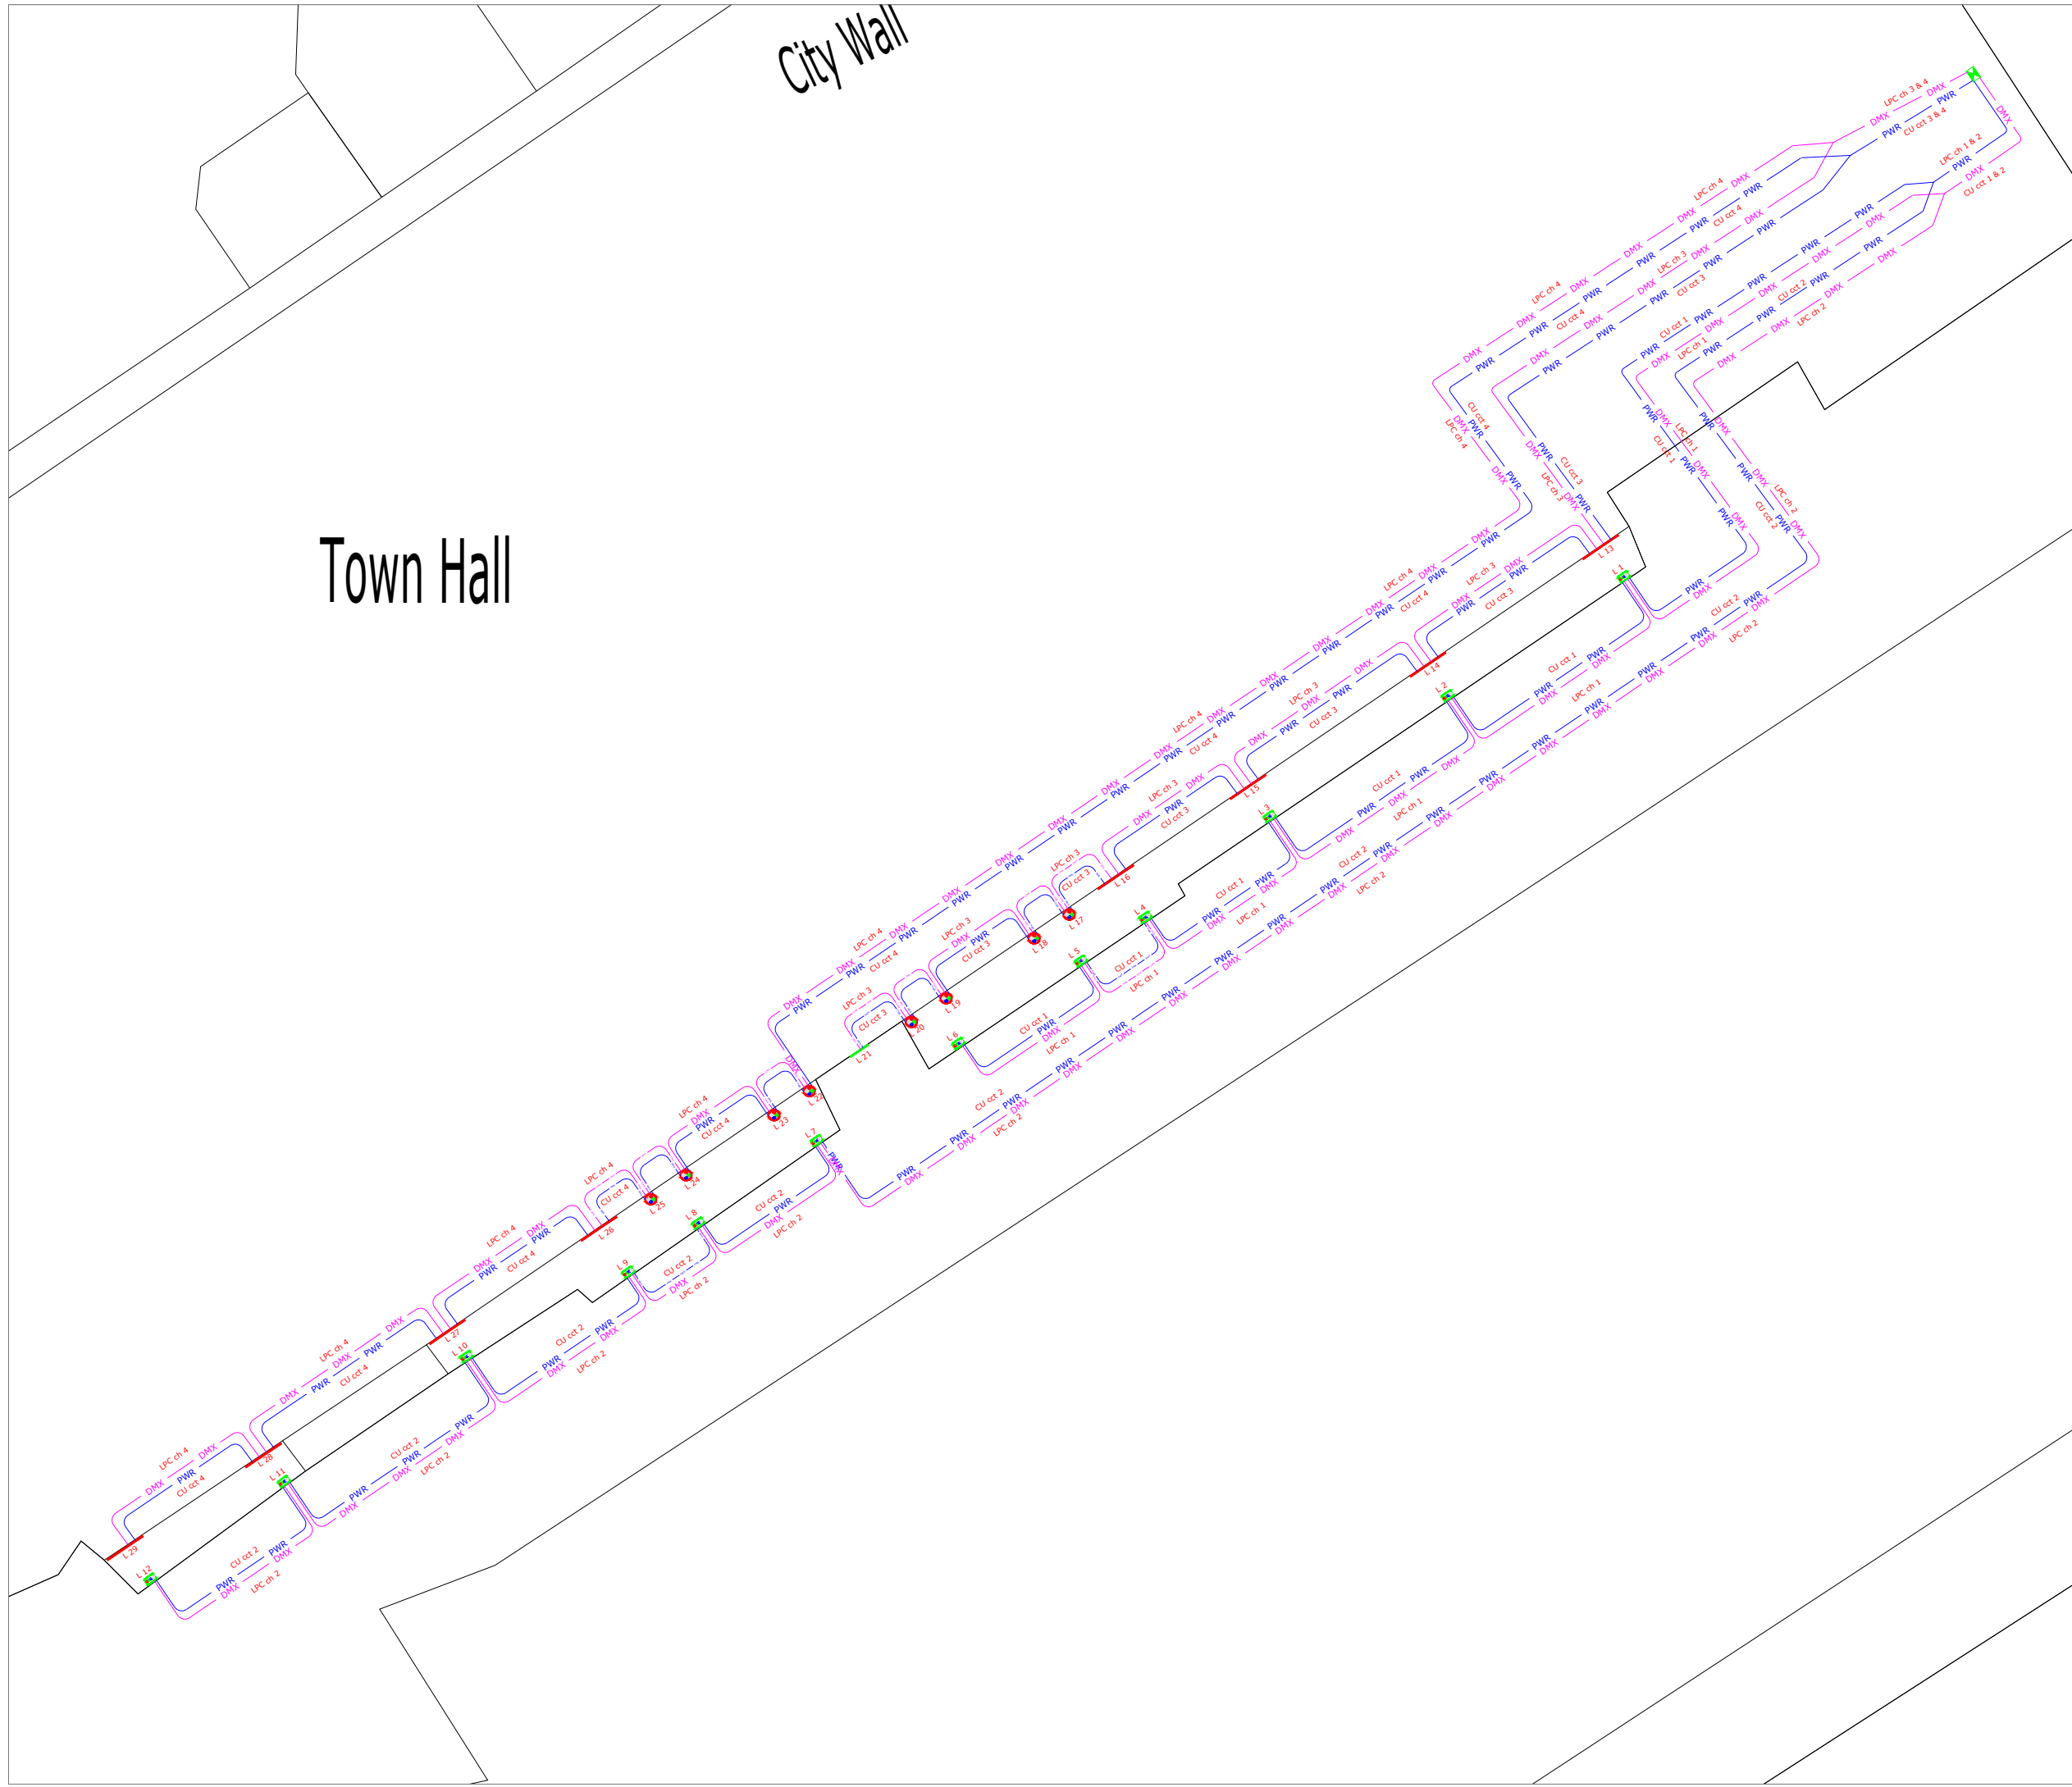

- Urbis Sculptflood 60 6297 RGBW elliptical horizontal Beam 32 Osion SSL 150 350mA 349472, complete with mounting kit and embellishment plate. Mounted on adjustable brackets, on rear of wall, close to ground level. 50W connected load at maximum output.
- Urbis Valinta Groove Midi 6662 RGBW flat glass narrow beam 28 Osion SSL 150 460mA 516492, complete with mounting kit. Mounted on adjustable brackets, at base of columns. 20W connected load at maximum output.
- Urbis Sculptline S100 6291 flat glass RGBW flat PMMA striated diffuser 10 Osion SSL 150 700mA 346982, complete with mounting kit and embellishment plate. Mounted on adjustable brackets. To be fixed using chemical anchors only. 50W connected load at maximum output.
- Urbis Sculptline S50 6291 RGBW Diffuser P25 striated 20 Osion SSL 150 350mA 346982, complete with mounting kit and embellishment plate. Mounted on adjustable brackets, on wall. 25W connected load at maximum output.
- Urbis Lighting Playback Controller, Urbis DMX Splitter, and Urbis Cellular Router to be installed close to the consumer unit within the building.

Contractor will be required to find appropriate routing for cables within the building.

All cables to be installed and connections made in accordance with I.S. 10101: Latest version.

Be advised that other services may exist that are not shown on this drawing. This drawing should not be taken as definitive or an indication that it is safe to dig.

Drawing title: As Built Illumination Layout		
Project title: Fáilte Ireland Urban Animation ~ City Hall & Mayor's Treasury		
Client: Waterford City & County Council		
Project number: 22007	Date: 04/06/2025	Hard copy approved:
Drawing number: 22007 - 1A	Revision: 0	Drawn by: Patrick Redmond
Read in conjunction with associated lighting calculations		
Do not scale from drawing		All dimensions in metres
Document control: TD 09		Version: 1.0
Redmond Analytical Management Services Ltd. Rosewood House, Mount Seaton, Camolin, Enniscorthy, Co. Wexford. Y21 K8P3 086 2356356 info@redmondams.ie www.redmondams.ie		



MSLL ~ Society of Light and Lighting

MILP ~ Institution of Lighting Professionals





- © COPYRIGHT RESERVED (Redmond AMS Ltd.)
- Urbis Sculptflood 60 6297 RGBW elliptical horizontal Beam 32 Oslon SSL 150 350mA 349472, complete with mounting kit and embellishment plate. Mounted on adjustable brackets, on rear of wall, close to ground level. 50W connected load at maximum output.
 - Urbis Valinta Groove Midi 6662 RGBW flat glass narrow beam 28 Oslon SSL 150 460mA 516492, complete with mounting kit. Mounted on adjustable brackets, at base of columns. 20W connected load at maximum output.
 - Urbis Sculptline S100 6291 flat glass RGBW flat PMMA striated diffuser 10 Oslon SSL 150 700mA 346982, complete with mounting kit and embellishment plate. Mounted on adjustable brackets. To be fixed using chemical anchors only. 50W connected load at maximum output.
 - Urbis Sculptline S50 6291 RGBW Diffuser P25 striated 20 Oslon SSL 150 350mA 346982, complete with mounting kit and embellishment plate. Mounted on adjustable brackets, on wall. 25W connected load at maximum output.
 - Urbis Lighting Playback Controller, Urbis DMX Splitter, and Urbis Cellular Router to be installed close to the consumer unit within the building.
- Contractor will be required to find appropriate routing for cables within the building.
- All cables to be installed and connections made in accordance with I.S. 10101: Latest version.

Be advised that other services may exist that are not shown on this drawing. This drawing should not be taken as definitive or an indication that it is safe to dig.		
Drawing title: As Built Illumination Layout		
Project title: Fáilte Ireland Urban Animation ~ City Hall & Mayor's Treasury		
Client: Waterford City & County Council		
Project number: 22007	Date: 04/06/2025	Hard copy approved:
Drawing number: 22007 - 2A	Revision: 0	Drawn by: Patrick Redmond
Read in conjunction with associated lighting calculations		
Do not scale from drawing	All dimensions in metres	
Document control: TD 09	Version: 1.0	
Redmond Analytical Management Services Ltd. Rosewood House, Mount Seaton, Camolin, Enniscorthy, Co. Wexford. Y21 K8P3		
086 2356356	info@redmondams.ie	www.redmondams.ie




REDMOND
ANALYTICAL MANAGEMENT SERVICES
LIGHTING | ENERGY | DESIGN | SUPPORT

MSLL ~ Society of Light and Lighting

MILP ~ Institution of Lighting Professionals



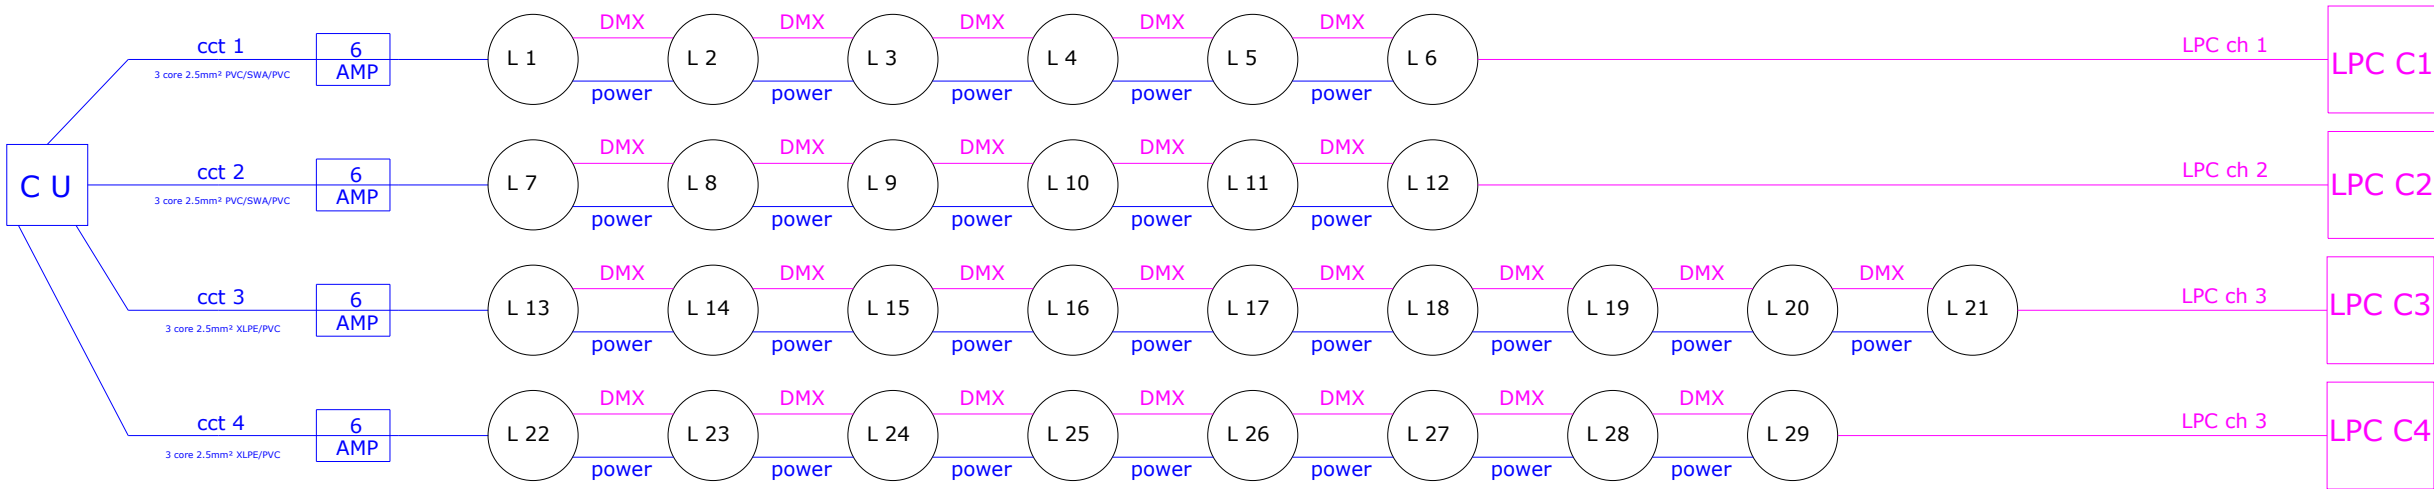

- Urbis Sculptflood 60 6297 RGBW elliptical horizontal Beam 32 Osion SSL 150 350mA 349472, complete with mounting kit and embellishment plate. Mounted on adjustable brackets, on rear of wall, close to ground level. 50W connected load at maximum output.
- Urbis Valinta Groove Midi 6662 RGBW flat glass narrow beam 28 Osion SSL 150 460mA 516492, complete with mounting kit. Mounted on adjustable brackets, at base of columns. 20W connected load at maximum output.
- Urbis Sculptline S100 6291 flat glass RGBW flat PMMA striated diffuser 10 Osion SSL 150 700mA 346982, complete with mounting kit and embellishment plate. Mounted on adjustable brackets. To be fixed using chemical anchors only. 50W connected load at maximum output.
- Urbis Sculptline S50 6291 RGBW Diffuser P25 striated 20 Osion SSL 150 350mA 346982, complete with mounting kit and embellishment plate. Mounted on adjustable brackets, on wall. 25W connected load at maximum output.
- Urbis Lighting Playback Controller, Urbis DMX Splitter, and Urbis Cellular Router to be installed close to the consumer unit within the building.

Contractor will be required to find appropriate routing for cables within the building.

All cables to be installed and connections made in accordance with I.S. 10101: Latest version.

Be advised that other services may exist that are not shown on this drawing. This drawing should not be taken as definitive or an indication that it is safe to dig.

Drawing title:
As Built Electrical Schematic

Project title:
Fáilte Ireland Urban Animation ~ City Hall & Mayor's Treasury

Client:
Waterford City & County Council

Project number: 22007	Date: 04/06/2025	Hard copy approved:
Drawing number: 22007 - 3A	Revision: 0	Drawn by: Patrick Redmond

Read in conjunction with associated lighting calculations

Do not scale from drawing All dimensions in metres

Document control: TD 09 Version: 1.0

Redmond Analytical Management Services Ltd.
Rosewood House, Mount Seaton, Camolin, Enniscorthy, Co. Wexford. Y21 K8P3

086 2356356 info@redmondams.ie www.redmondams.ie



MSLL ~ Society of Light and Lighting

MILP ~ Institution of Lighting Professionals

