


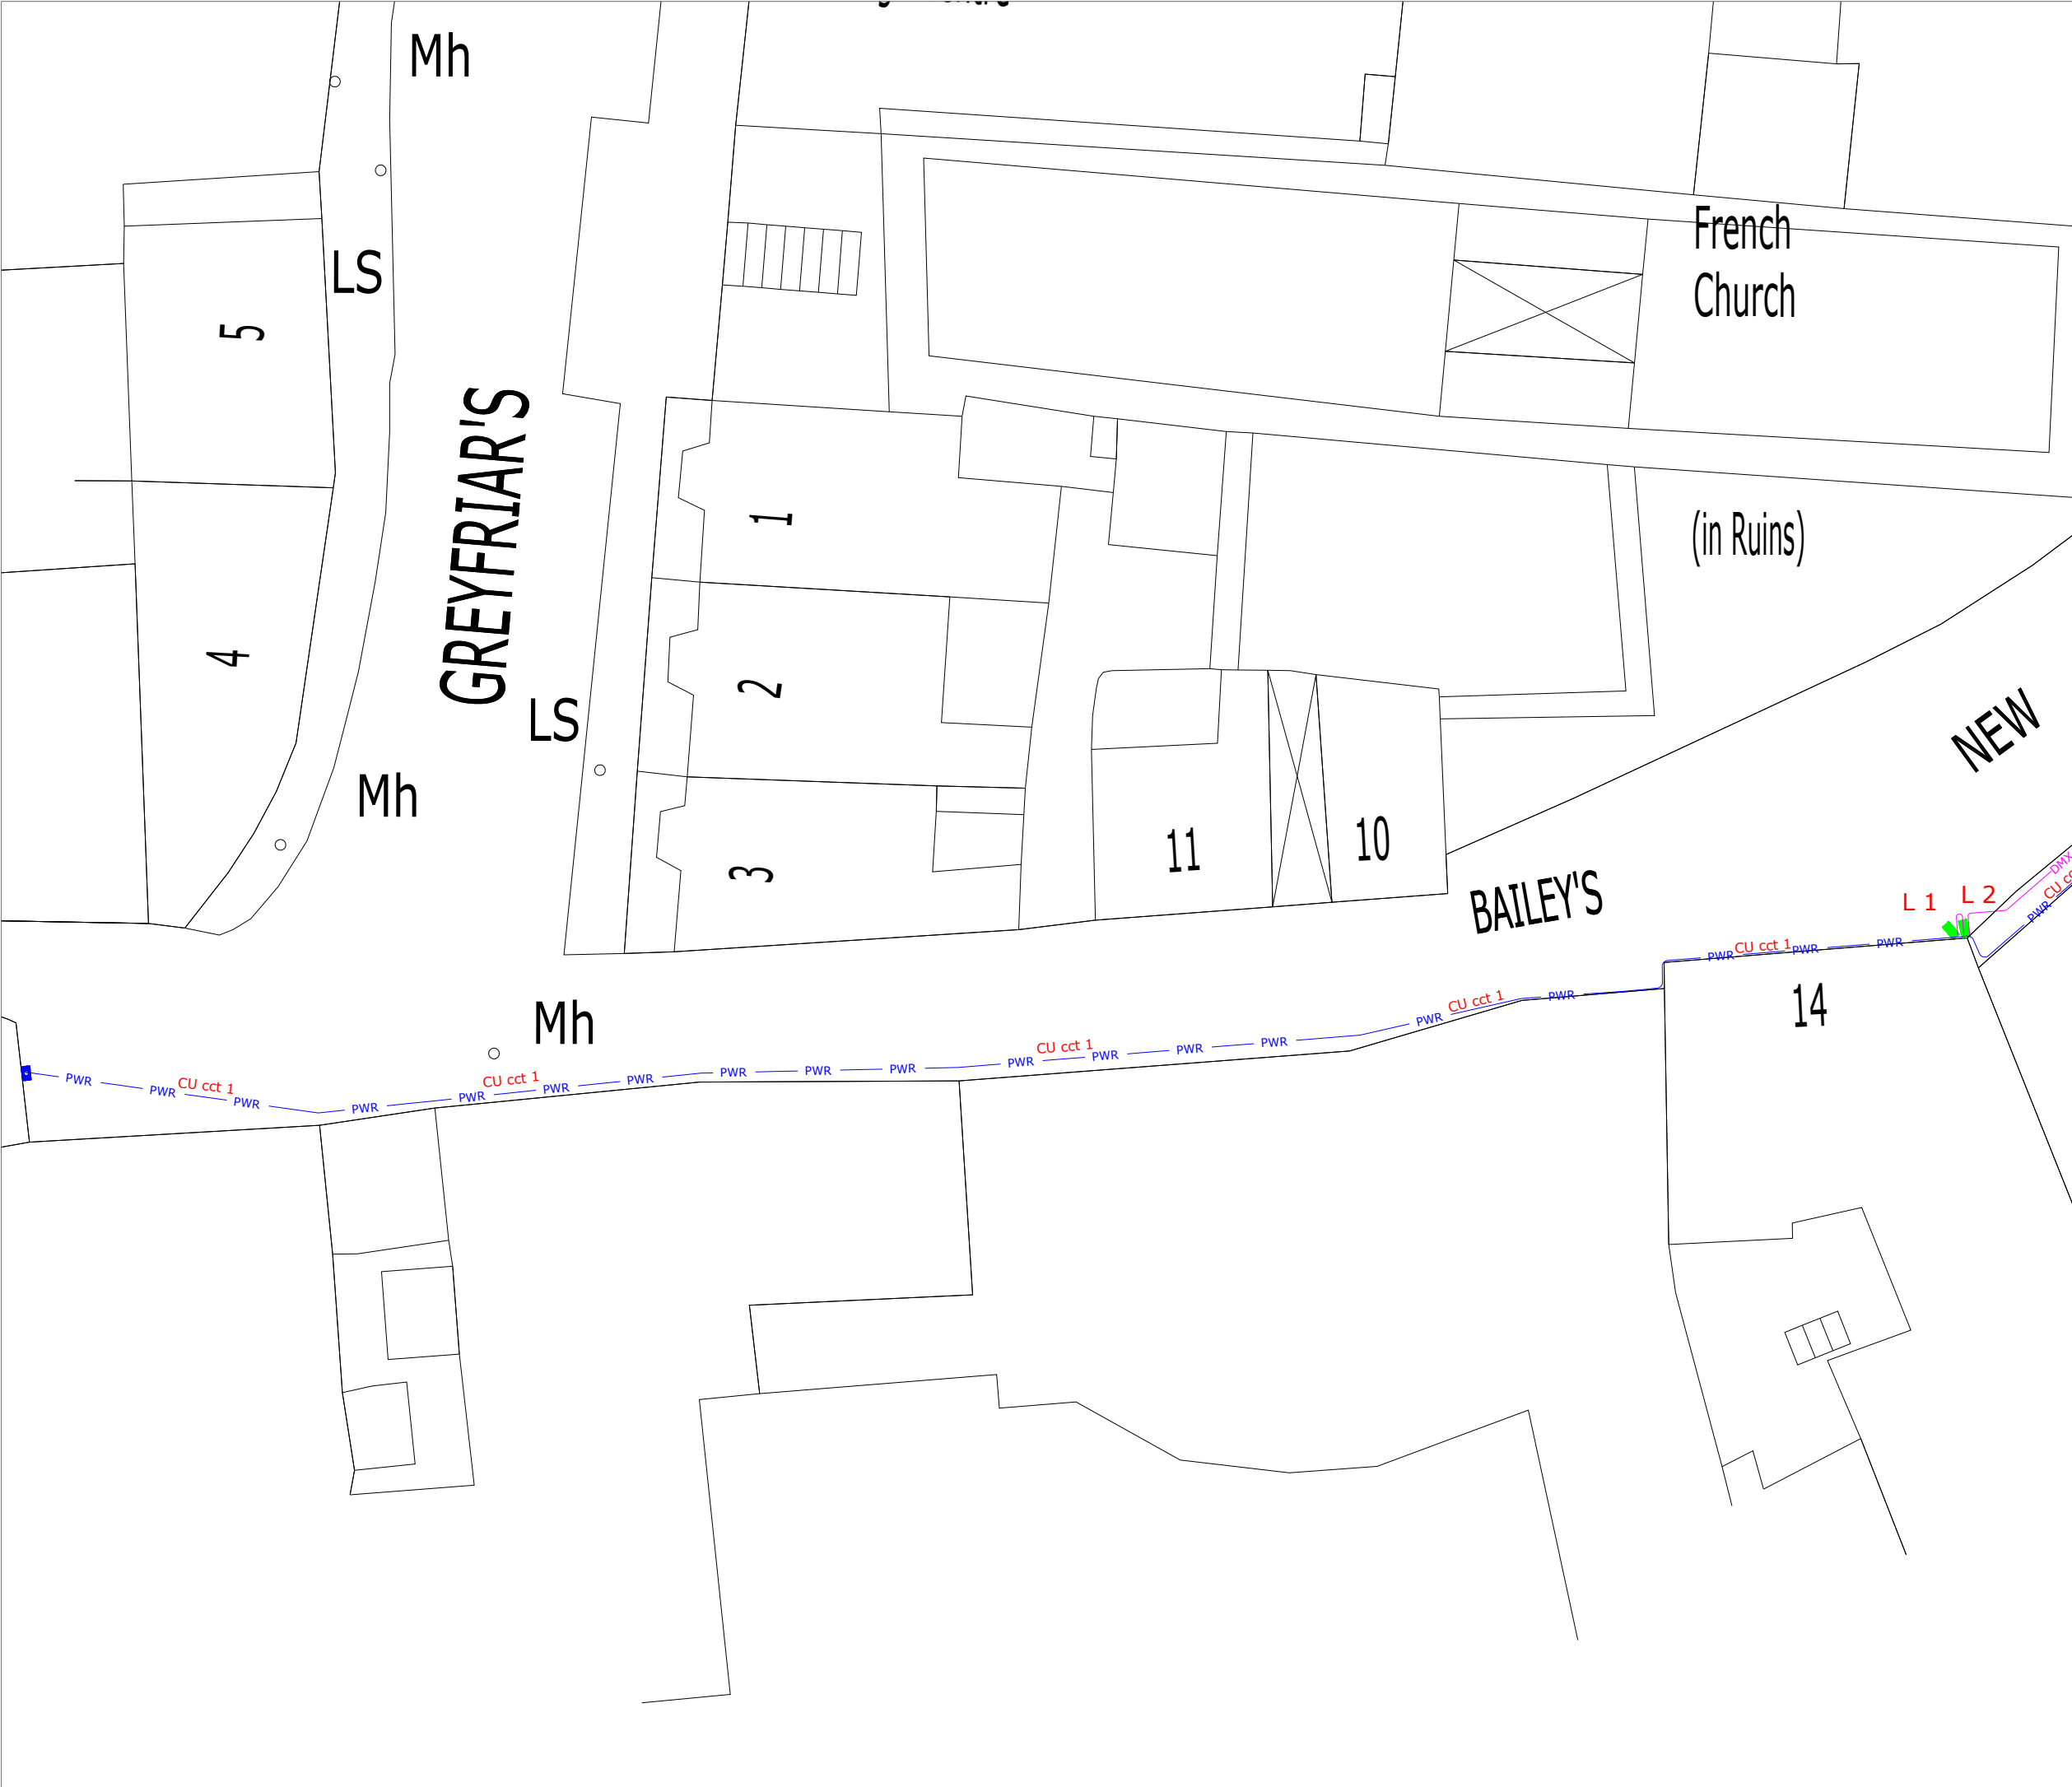

© COPYRIGHT RESERVED (Redmond AMS Ltd.)

Divum 50K. 37lm at 8880K. With internal line of sight WiFi, 4 GOBO rotator wheel, dynamic effect wheel, beam shaper and DMX driver. Mounted on wall, aimed at street surface. 600W connected load, each.

Metre cabinet providing power supply to projectors.

Metre cabinet providing DMX supply to projectors.

Be advised that other services may exist that are not shown on this drawing. This drawing should not be taken as definitive or an indication that it is safe to dig.

Drawing title:
As Built Illumination Layout

Project title:
Fáilte Ireland Urban Animation ~ French Church

Client:
Waterford City & County Council

Project number:
22009

Date:
11/06/2025

Hard copy approved:

Drawing number:
22009 - 1A

Revision:
0

Drawn by:
Patrick Redmond

Read in conjunction with associated lighting calculations

Do not scale from drawing

All dimensions in metres

Document control: TD 09

Version: 1.0

Redmond Analytical Management Services Ltd.

Rosewood House, Mount Seaton, Camolin, Enniscorthy, Co. Wexford. Y21 K8P3

086 2356356

info@redmondams.ie

www.redmondams.ie


REDMOND

ANALYTICAL MANAGEMENT SERVICES

LIGHTING | ENERGY | DESIGN | SUPPORT

MSLL ~ Society of Light and Lighting

MILP ~ Institution of Lighting Professionals

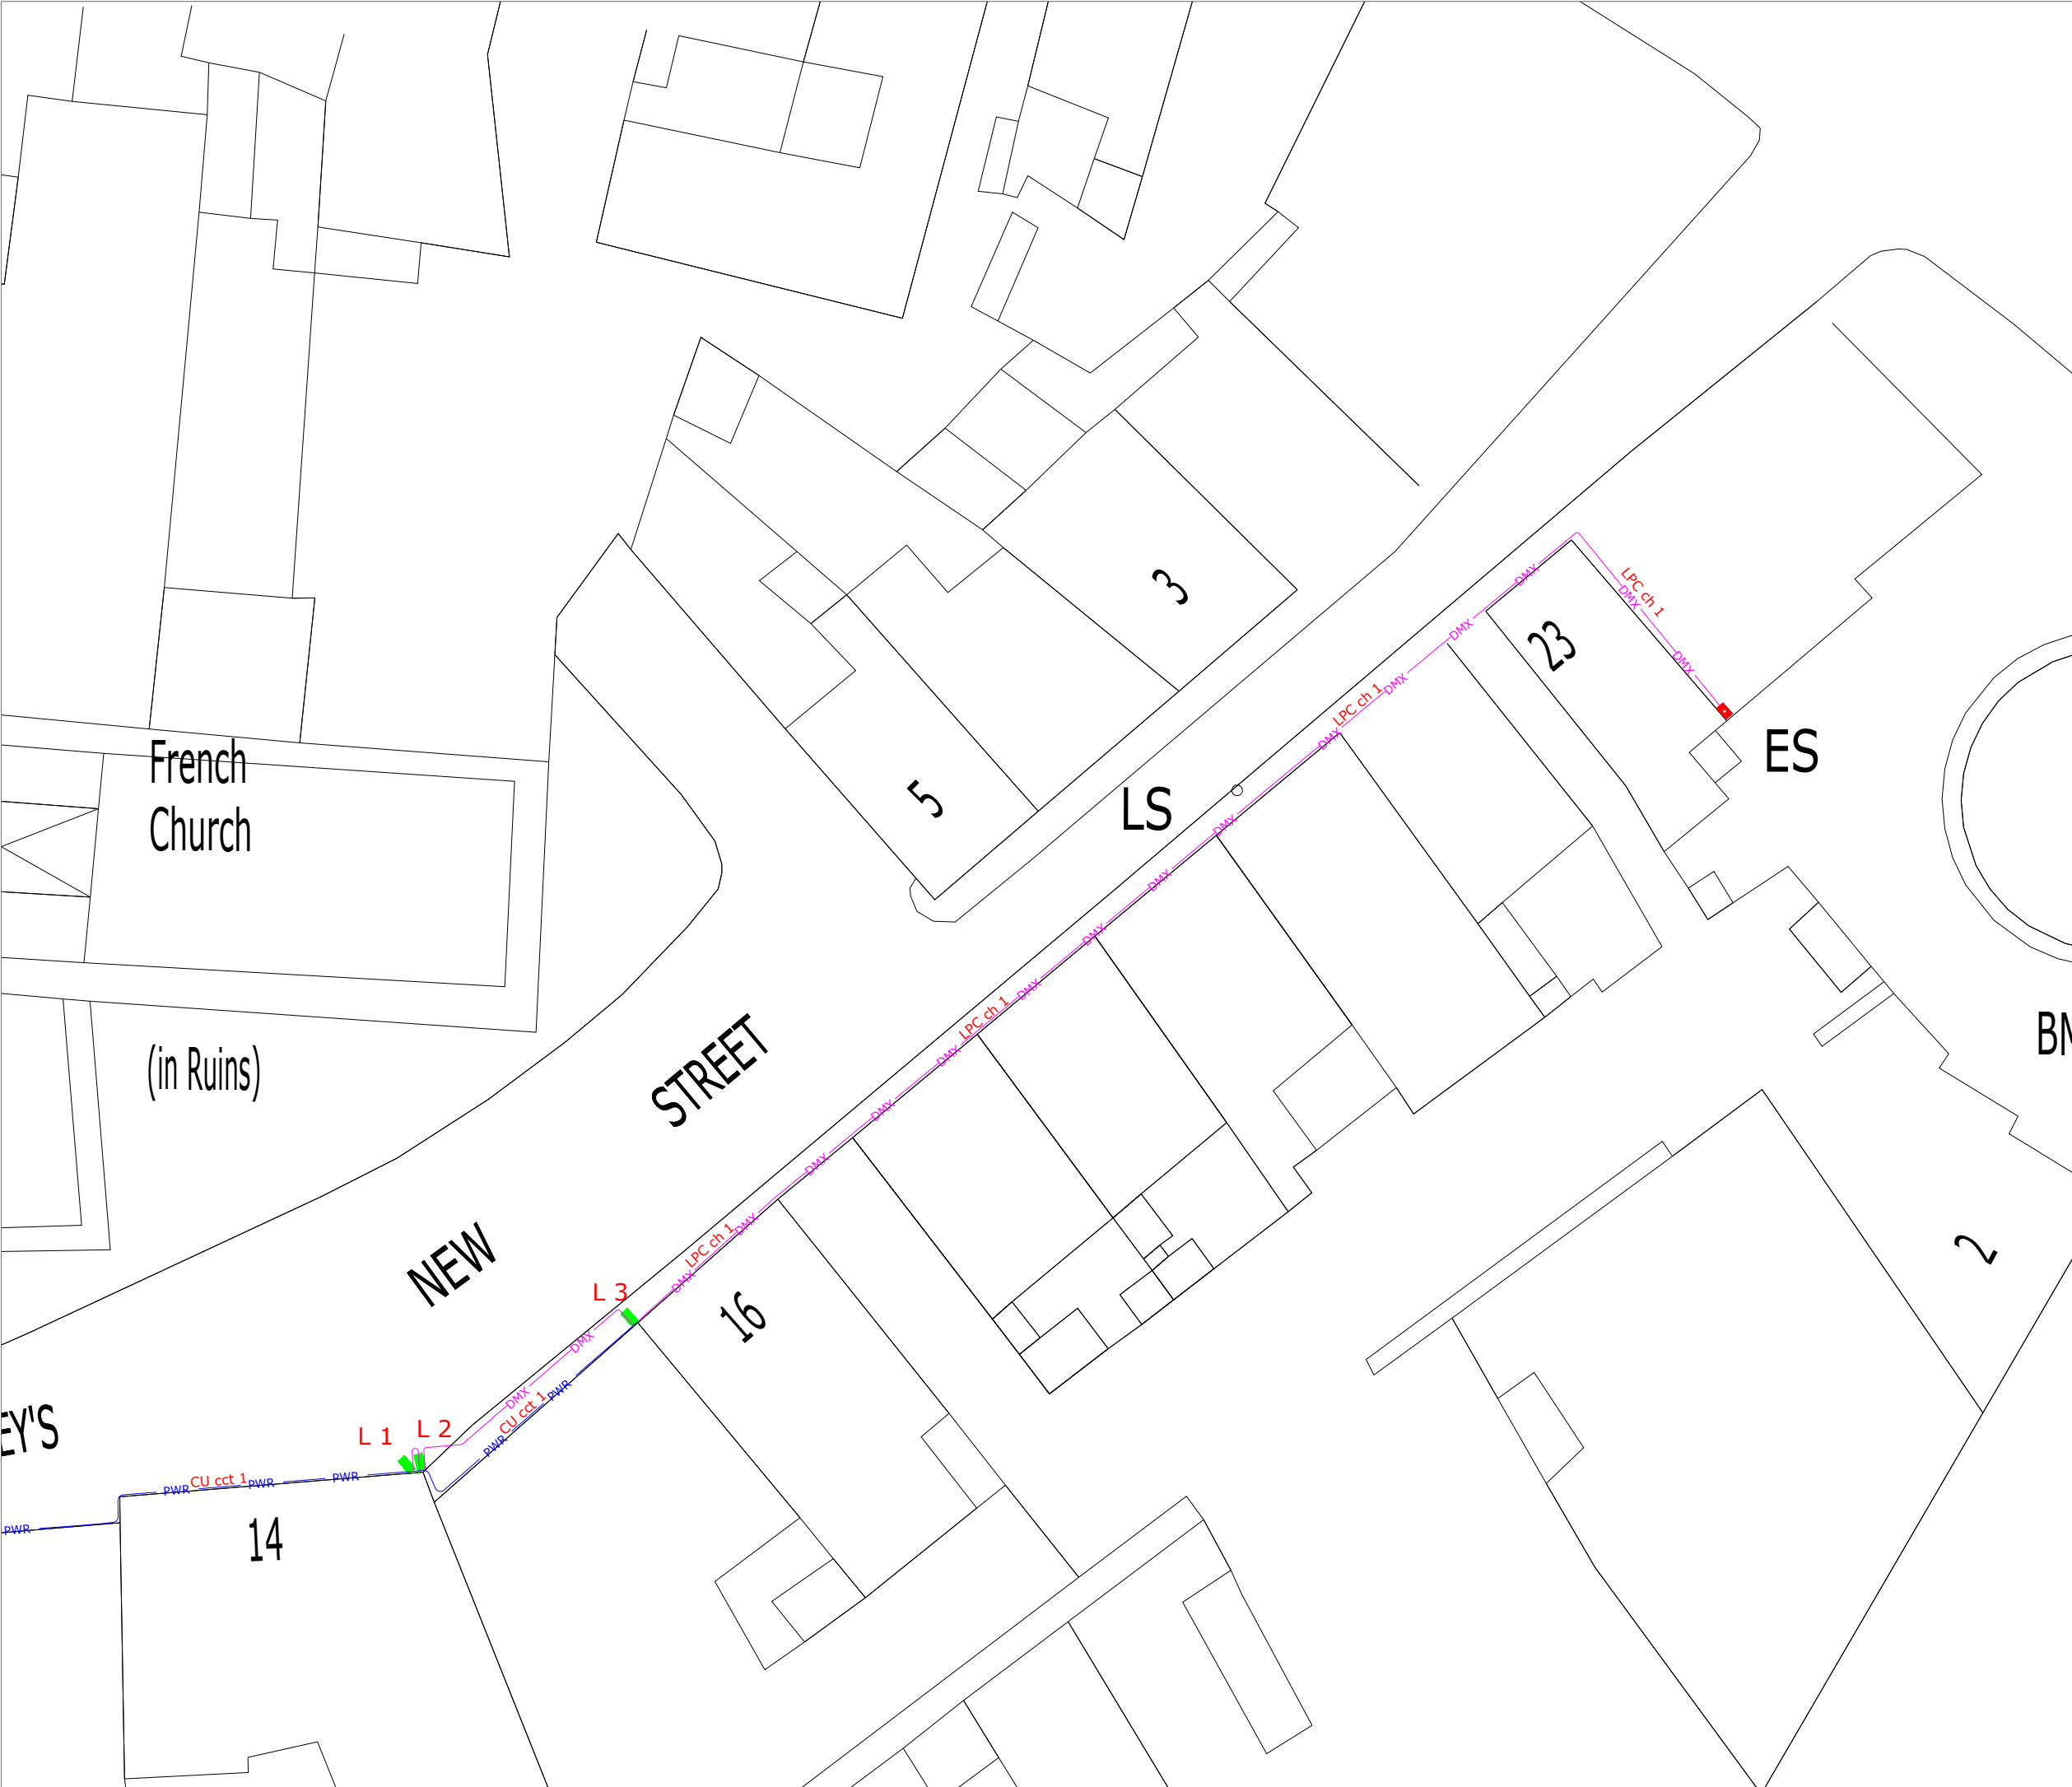

© COPYRIGHT RESERVED (Redmond AMS Ltd.)

Divum 50K. 37lm at 8880K. With internal line of sight WiFi, 4 GOBO rotator wheel, dynamic effect wheel, beam shaper and DMX driver. Mounted on wall, aimed at street surface. 600W connected load, each.

Metre cabinet providing power supply to projectors.

Metre cabinet providing DMX supply to projectors.

Be advised that other services may exist that are not shown on this drawing. This drawing should not be taken as definitive or an indication that it is safe to dig.

Drawing title:

As Built Illumination Layout

Project title:

Fáilte Ireland Urban Animation ~ French Church

Client:

Waterford City & County Council

Project number:

22009

Date:

11/06/2025

Hard copy approved:

Drawing number:

22009 - 2A

Revision:

0

Drawn by:

Patrick Redmond

Read in conjunction with associated lighting calculations

Do not scale from drawing

All dimensions in metres

Document control: TD 09

Version: 1.0

Redmond Analytical Management Services Ltd.

Rosewood House, Mount Seaton, Camolin, Enniscorthy, Co. Wexford. Y21 K8P3

086 2356356 | info@redmondams.ie | www.redmondams.ie


REDMOND

ANALYTICAL MANAGEMENT SERVICES

LIGHTING | ENERGY | DESIGN | SUPPORT

MSLL ~ Society of Light and Lighting

MILP ~ Institution of Lighting Professionals

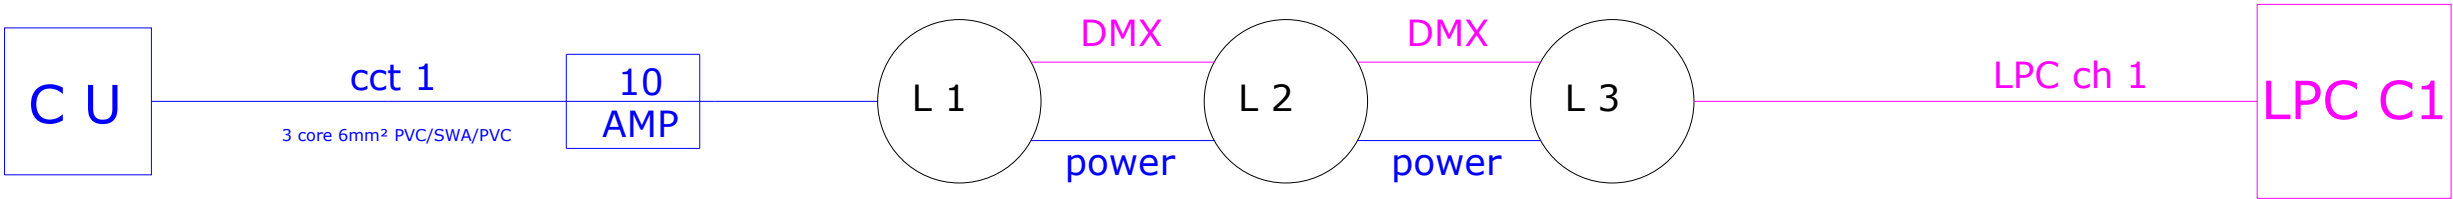

-  Divum 50K. 37lm at 8880K. With internal line of sight WiFi, 4 GOBO rotator wheel, dynamic effect wheel, beam shaper and DMX driver. Mounted on wall, aimed at street surface. 600W connected load, each.
-  Metre cabinet providing power supply to projectors.
-  Metre cabinet providing DMX supply to projectors.

Be advised that other services may exist that are not shown on this drawing. This drawing should not be taken as definitive or an indication that it is safe to dig.

Drawing title: As Built Electrical Schematic		
Project title: Fáilte Ireland Urban Animation ~ French Church		
Client: Waterford City & County Council		
Project number: 22009	Date: 11/06/2025	Hard copy approved:
Drawing number: 22009 - 3A	Revision: 0	Drawn by: Patrick Redmond
Read in conjunction with associated lighting calculations		
Do not scale from drawing	All dimensions in metres	
Document control: TD 09	Version: 1.0	
Redmond Analytical Management Services Ltd. Rosewood House, Mount Seaton, Camolin, Enniscorthy, Co. Wexford. Y21 K8P3		
086 2356356	info@redmondams.ie	www.redmondams.ie

