


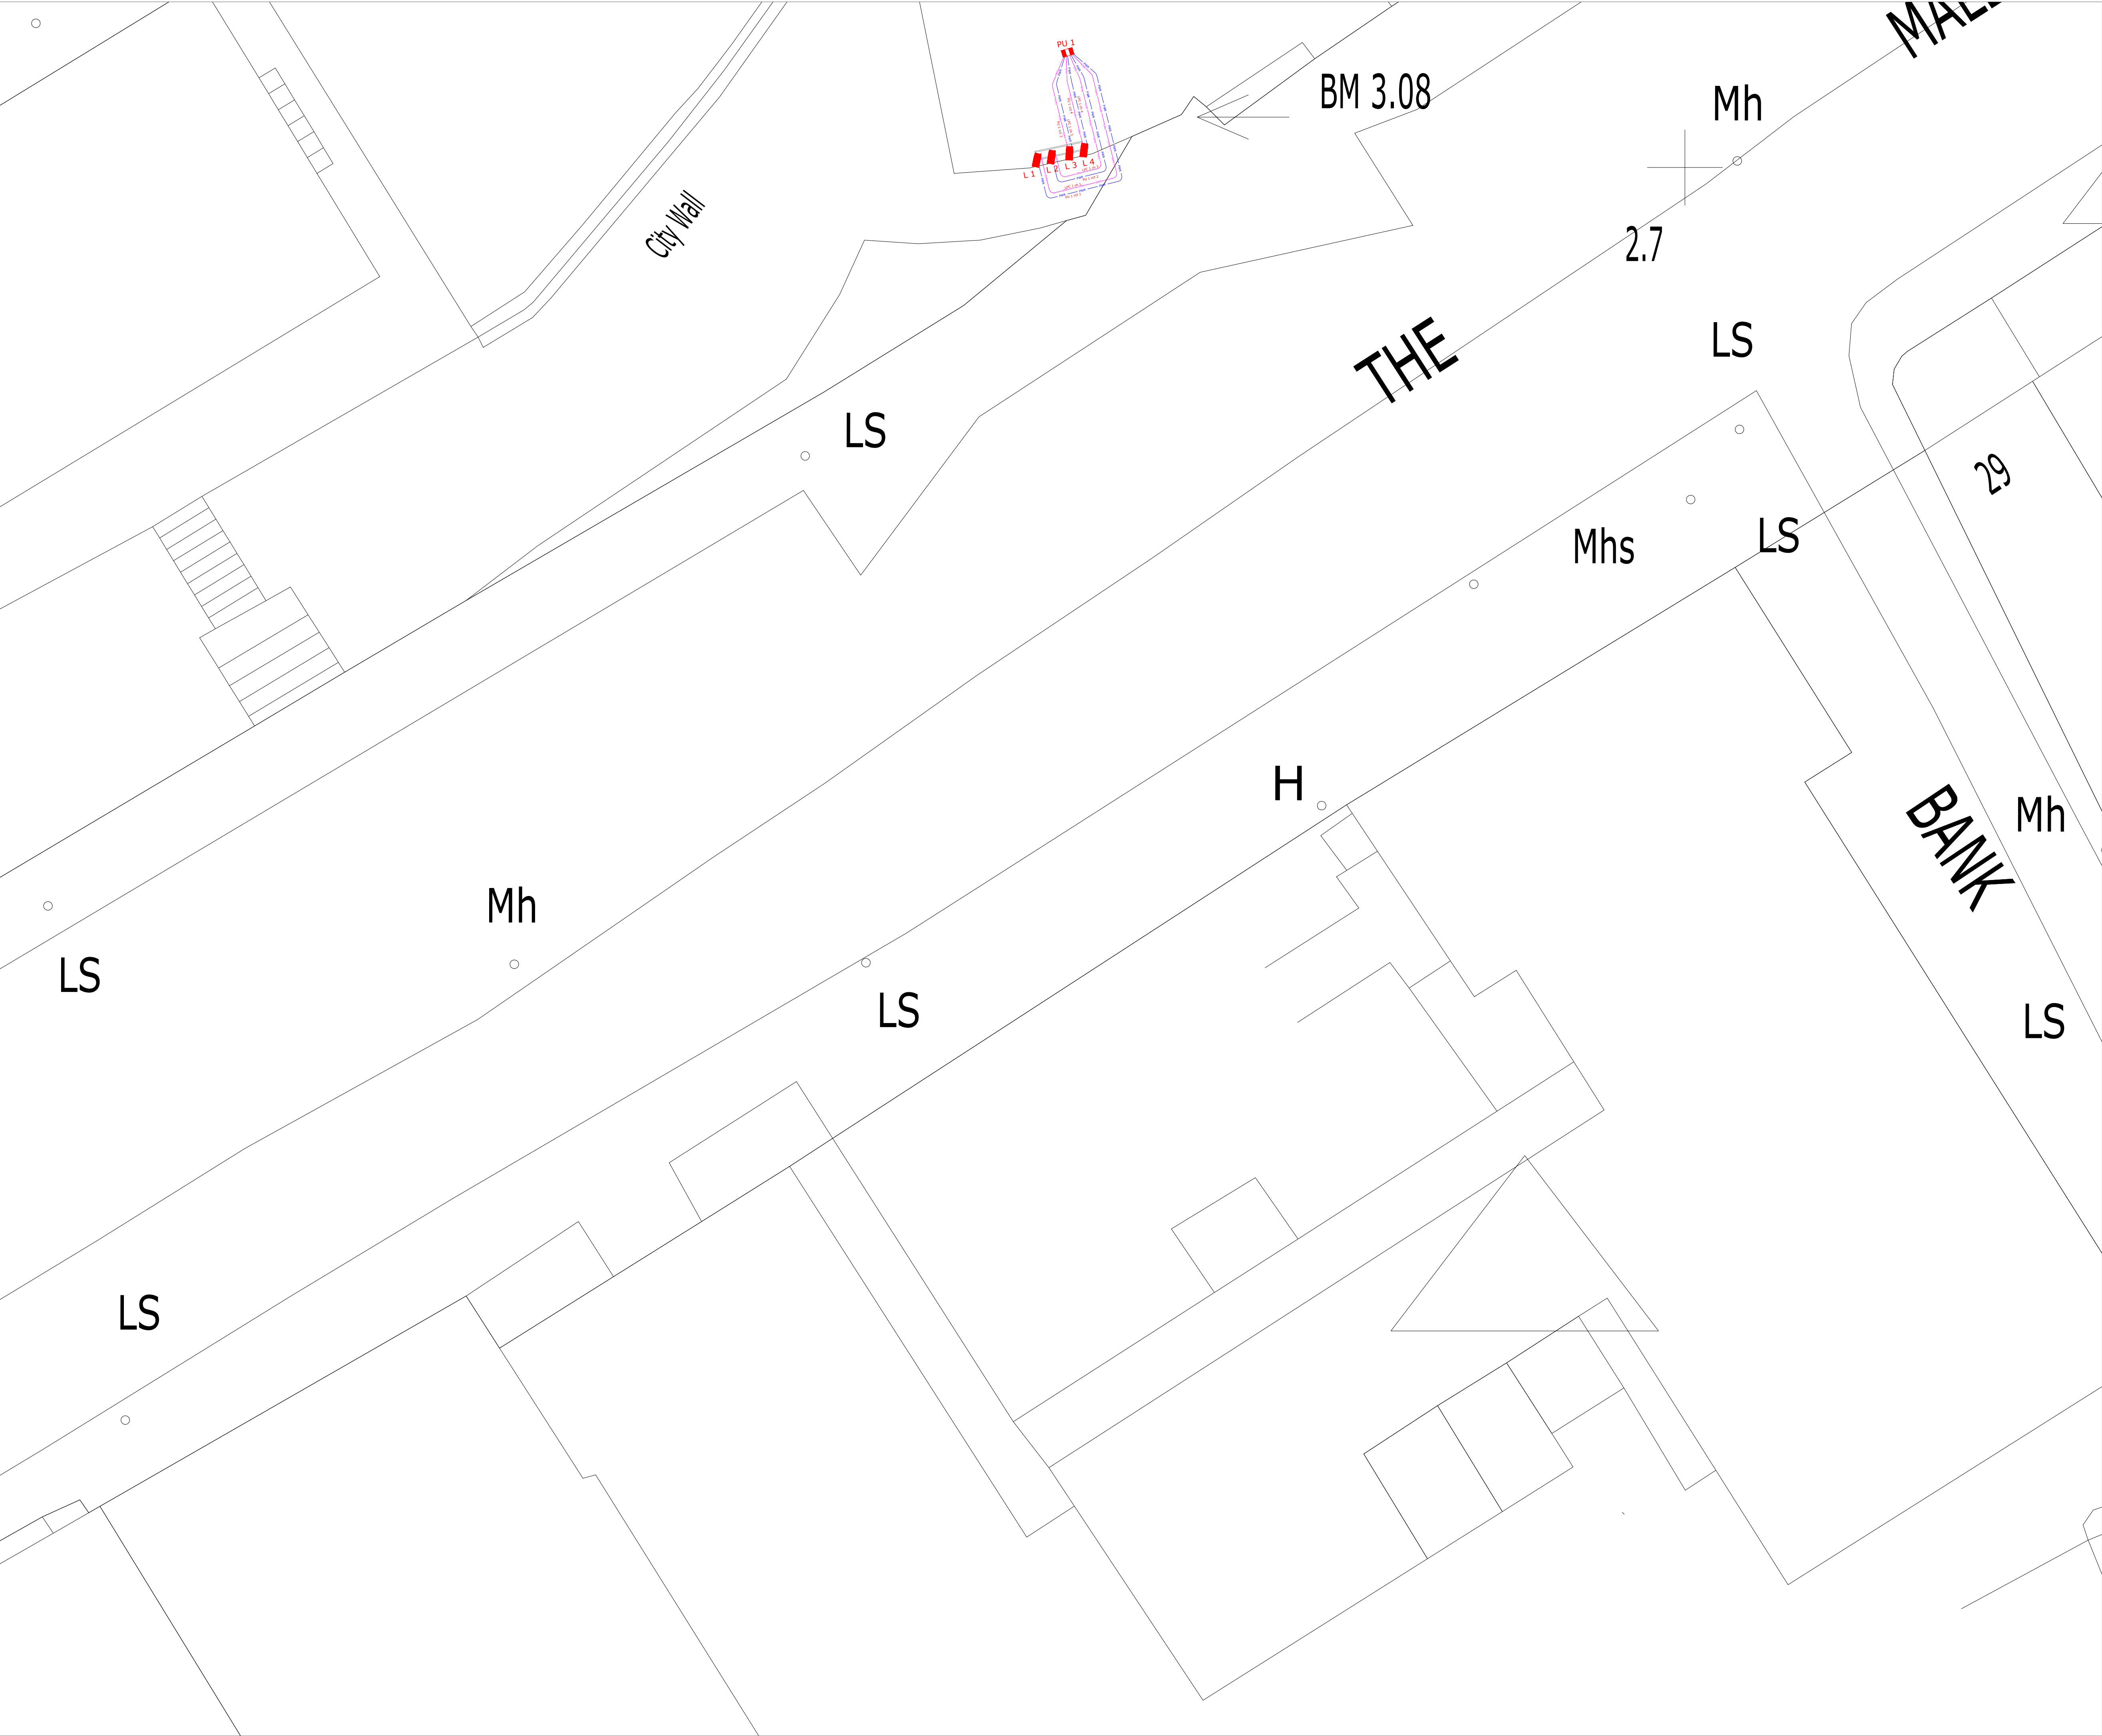

 Divum 50K. 37lm at 8880K. With internal line of sight WiFi, 4 Gobo rotator wheel, dynamic effect wheel, beam shaper and DMX driver. Mounted on free standing frame, on roof, aimed towards building facade. 600W connected load.

 Urbis Lighting Playback Controller, Urbis DMX Splitter, and Urbis Cellular Router to be installed close to the consumer unit within the building.

Be advised that other services may exist that are not shown on this drawing. This drawing should not be taken as definitive or an indication that it is safe to dig.

Drawing title: Illumination Layout ~ As Built		
Project title: Fáilte Ireland Urban Animation ~ House of Waterford Crystal		
Client: Waterford City & County Council		
Project number: 22011	Date: 112/07/2025	Hard copy approved:
Drawing number: 22011 - 1	Revision: 0	Drawn by: Patrick Redmond
Read in conjunction with associated lighting calculations		
Do not scale from drawing		All dimensions in mm
Document control: TD 09	Version: 1.0	


Redmond Analytical Management Services Ltd.
053 9231112 | info@redmondams.ie | www.redmondams.ie



MSLL ~ Society of Light and Lighting

MILP ~ Institution of Lighting Professionals



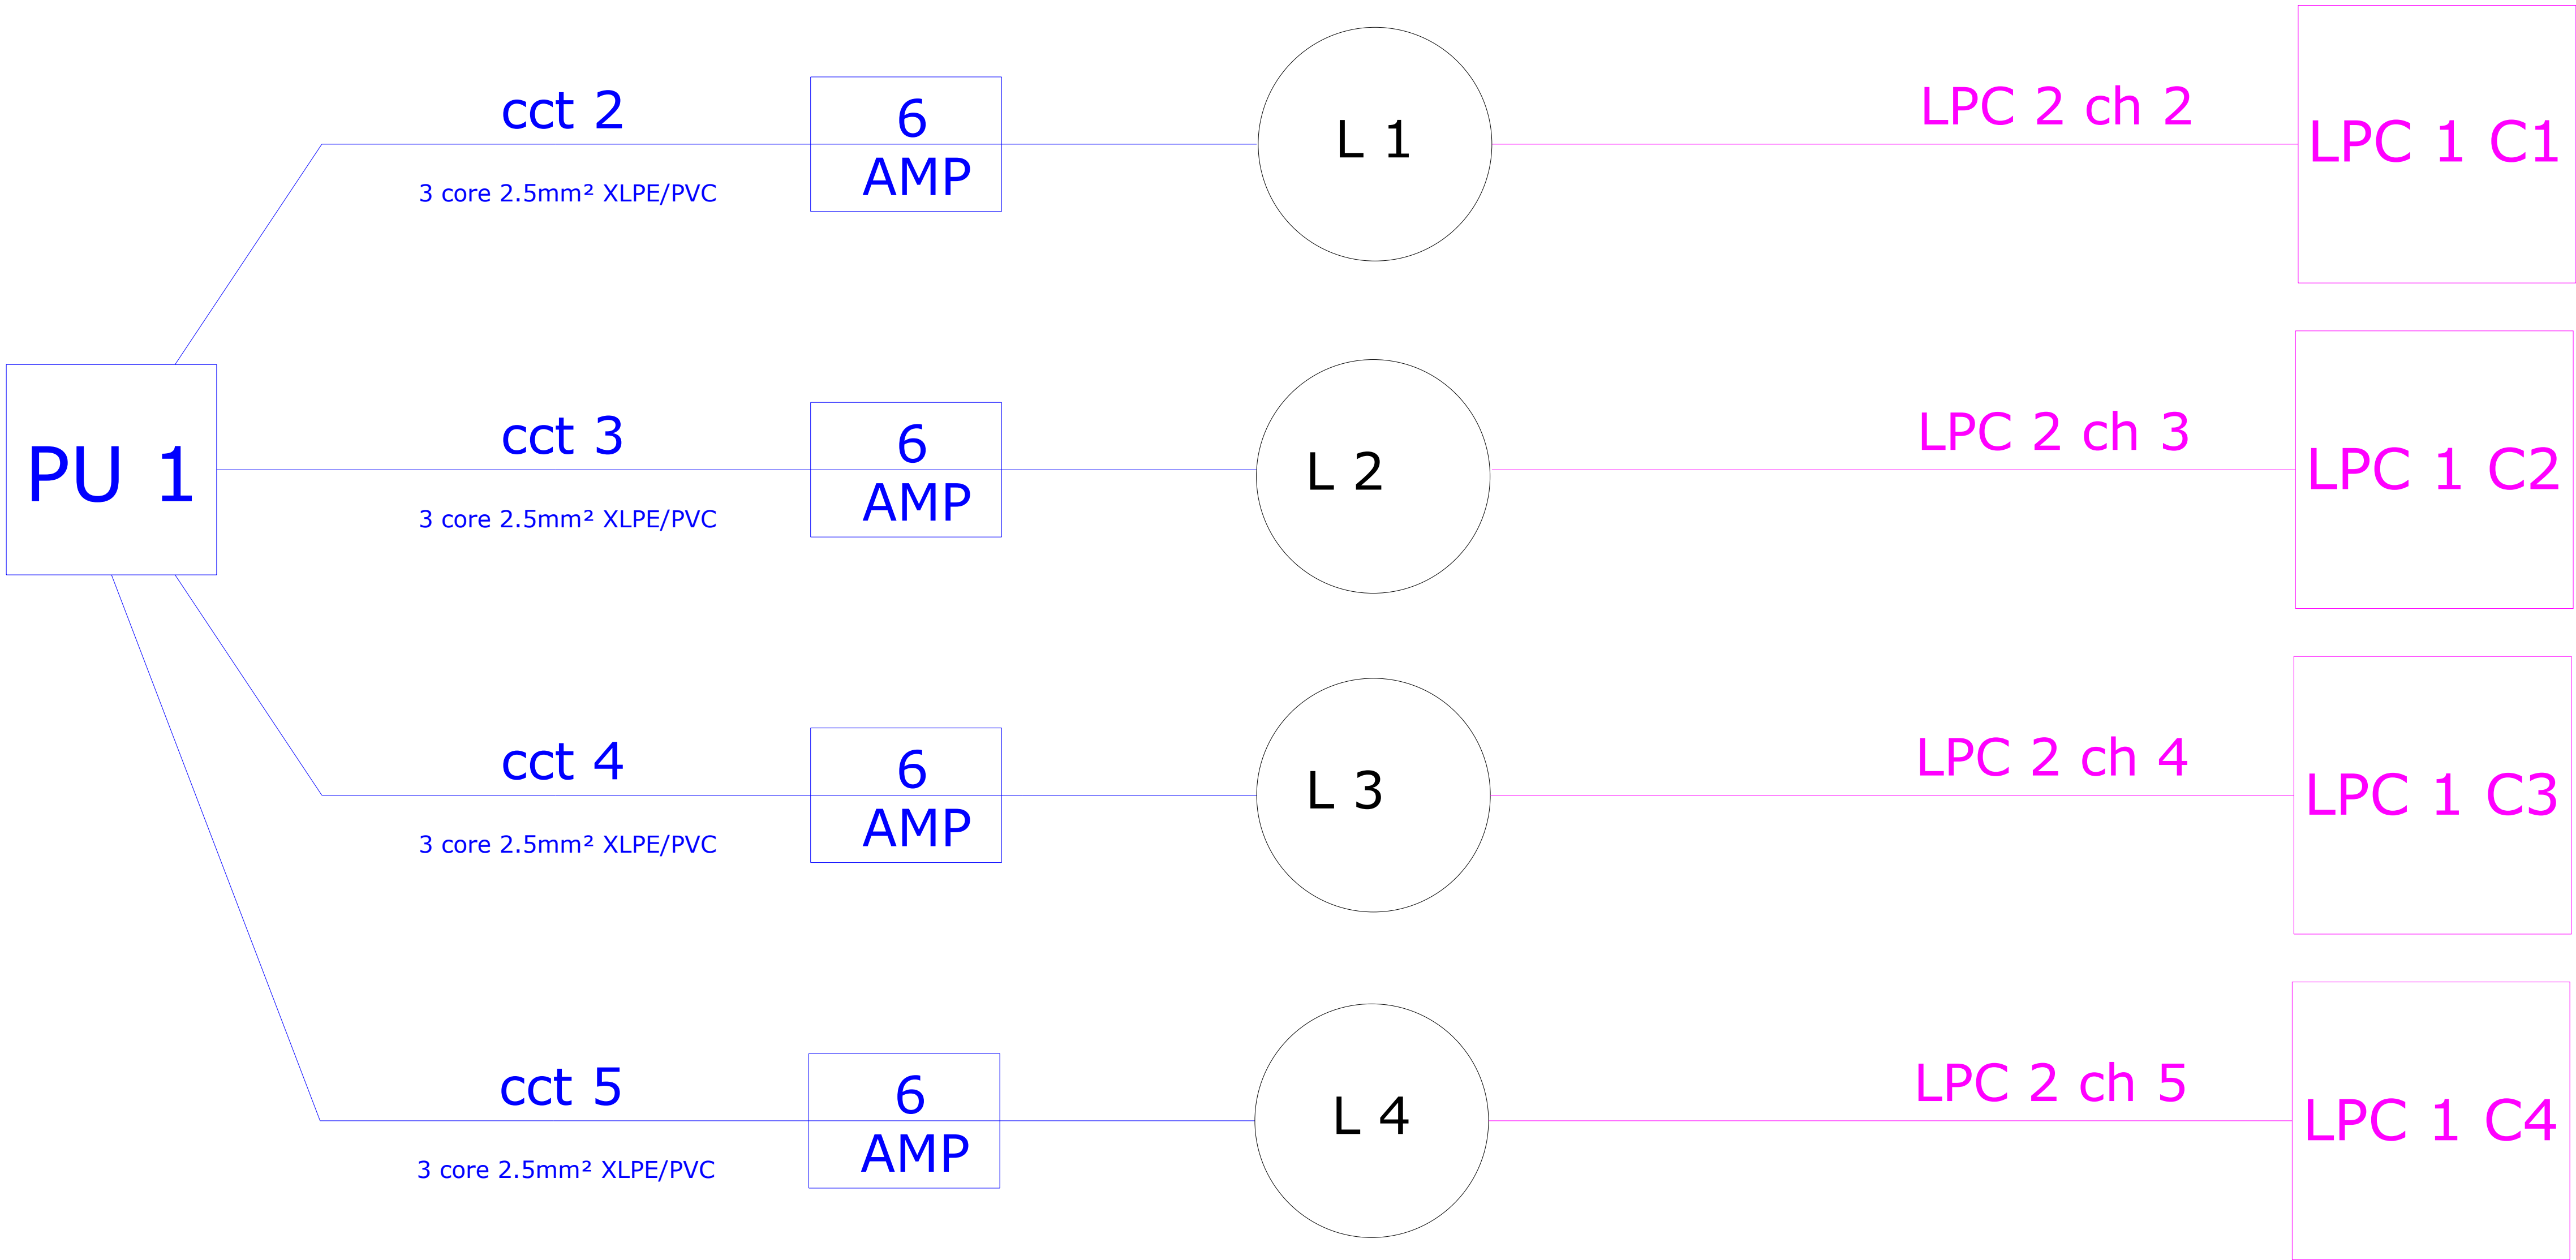

 Divum 50K. 37lm at 8880K. With internal line of sight WiFi, 4 GOBO rotator wheel, dynamic effect wheel, beam shaper and DMX driver. Mounted on free standing frame, on roof, aimed towards building facade. 600W connected load.

 Urbis Lighting Playback Controller, Urbis DMX Splitter, and Urbis Cellular Router to be installed close to the consumer unit within the building.

Be advised that other services may exist that are not shown on this drawing. This drawing should not be taken as definitive or an indication that it is safe to dig.

Drawing title: Electrical Schematic ~ As Built		
Project title: Fáilte Ireland Urban Animation ~ House of Waterford Crystal		
Client: Waterford City & County Council		
Project number: 22011	Date: 12/07/2025	Hard copy approved:
Drawing number: 22011 - 2	Revision: 0	Drawn by: Patrick Redmond
Read in conjunction with associated lighting calculations		
Do not scale from drawing		All dimensions in mm
Document control: TD 09	Version: 1.0	

Redmond Analytical Management Services Ltd.
053 9231112 | info@redmondams.ie | www.redmondams.ie



MSLL ~ Society of Light and Lighting

MILP ~ Institution of Lighting Professionals

