


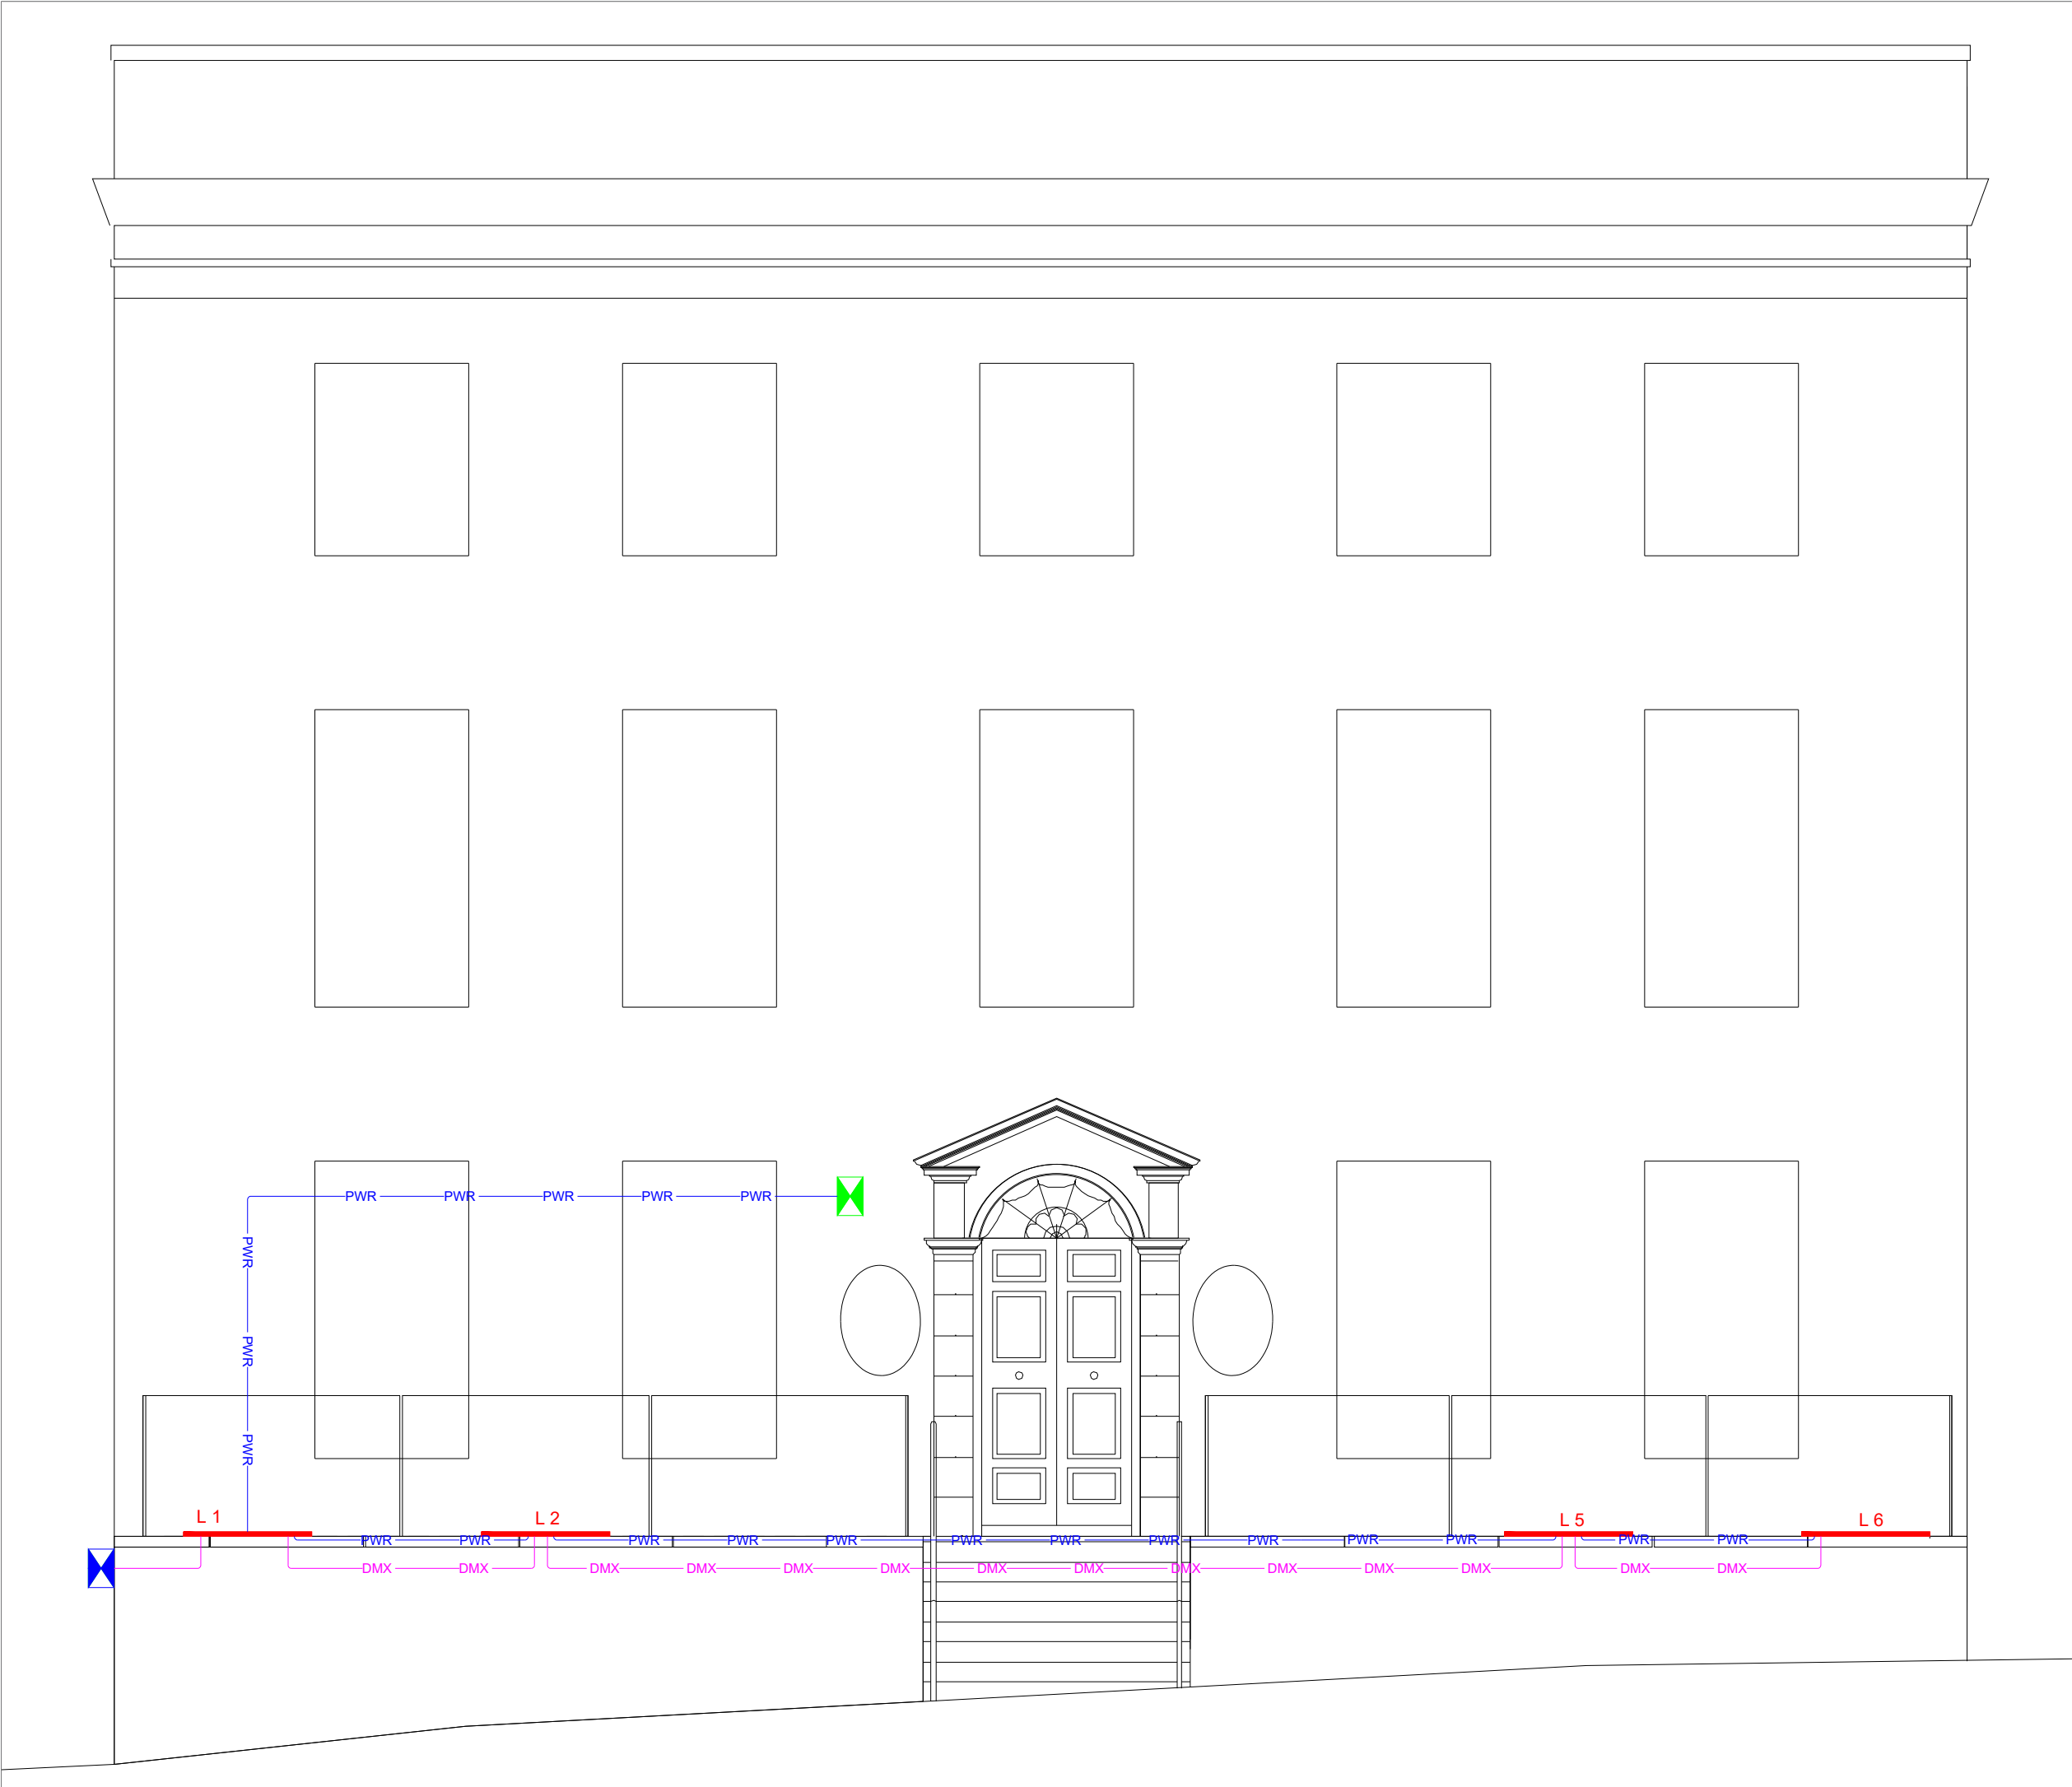

© COPYRIGHT RESERVED (Redmond AMS Ltd.)

Urbis Sculpture R100 6291 RGBW 40 Oscon SSL 150 350mA 346962, complete with mounting kit and embellishment plate. Surface mounted at ground level. 50W connected load at maximum output.

Urbis Lighting Playback Controller, Urbis DMX Splitter, and Urbis Cellular Router to be installed close to the consumer unit within the building.

Contractor will be required to find appropriate routing for cables within the building.

All cables to be installed and connections made in accordance with I.S. 10101: Latest version.

Power supply for luminaire.

Be advised that other services may exist that are not shown on this drawing. This drawing should not be taken as definitive or an indication that it is safe to dig.

Drawing title:  
As Built Illumination Layout

Project title:  
Fáilte Ireland Urban Animation ~ Irish Silver Museum

Client:  
Waterford City & County Council

|                               |                     |                              |
|-------------------------------|---------------------|------------------------------|
| Project number:<br>22012      | Date:<br>08/06/2025 | Hard copy approved:          |
| Drawing number:<br>22012 - 1A | Revision:<br>0      | Drawn by:<br>Patrick Redmond |

Read in conjunction with associated lighting calculations

Do not scale from drawing      All dimensions in metres


Document control: TD 09      Version: 1.0

**Redmond Analytical Management Services Ltd.**  
Rosewood House, Mount Seaton, Camolin, Enniscorthy, Co. Wexford. Y21 K8P3  
086 2356356      info@redmondams.ie      www.redmondams.ie

ANALYTICAL MANAGEMENT SERVICES  
LIGHTING | ENERGY | DESIGN | SUPPORT

MSLL ~ Society of Light and Lighting

MILP ~ Institution of Lighting Professionals

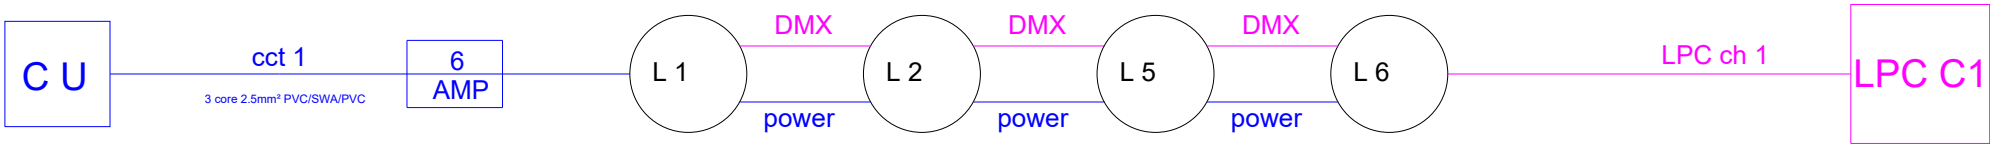

- Urbis Sculptline R100 6291 RGBW 40 Oscon SSL 150 350mA 346962, complete with mounting kit and embellishment plate. Surface mounted at ground level. 50W connected load at maximum output.
- ✕

Urbis Lighting Playback Controller, Urbis DMX Splitter, and Urbis Cellular Router to be installed close to the consumer unit within the building.  
  
Contractor will be required to find appropriate routing for cables within the building.  
  
All cables to be installed and connections made in accordance with I.S. 10101: Latest version.
- ✔

Power supply for luminaire.

Be advised that other services may exist that are not shown on this drawing. This drawing should not be taken as definitive or an indication that it is safe to dig.

|                                                                                                                                 |                     |                              |
|---------------------------------------------------------------------------------------------------------------------------------|---------------------|------------------------------|
| Drawing title:<br>As Built Electrical Schematic                                                                                 |                     |                              |
| Project title:<br>Fáilte Ireland Urban Animation ~ Irish Silver Museum                                                          |                     |                              |
| Client:<br>Waterford City & County Council                                                                                      |                     |                              |
| Project number:<br>22012                                                                                                        | Date:<br>08/06/2025 | Hard copy approved:          |
| Drawing number:<br>22012 - 2A                                                                                                   | Revision:<br>0      | Drawn by:<br>Patrick Redmond |
| Read in conjunction with associated lighting calculations                                                                       |                     |                              |
| Do not scale from drawing                                                                                                       |                     | All dimensions in metres     |
| Document control: TD 09                                                                                                         |                     | Version: 1.0                 |
| <b>Redmond Analytical Management Services Ltd.</b><br>Rosewood House, Mount Seaton, Camolin, Enniscorthy, Co. Wexford. Y21 K8P3 |                     |                              |
| 086 2356356                                                                                                                     | info@redmondams.ie  | www.redmondams.ie            |