

LS

1

LS

6

L 1
L 2
L 3


CU cct 1
LPC ch 1

Hall

- Divum 50K. 37lm at 8880K. With internal line of sight WiFi, 4 Gobo rotator wheel, beam shaper and DMX driver. Mounted on Wall brackets between first floor and second floor windows on building opposite. 600W connected load.
- Cabinet providing power supply and DMX supply to projectors.

Be advised that other services may exist that are not shown on this drawing. This drawing should not be taken as definitive or an indication that it is safe to dig.		
Drawing title: Illumination Layout ~ As Built		
Project title: Fáilte Ireland Urban Animation ~ Irish Museum of Science & The Storey of Time		
Client: Waterford City & County Council		
Project number: 22013	Date: 17/06/2025	Hard copy approved:
Drawing number: 22013 - 1A	Revision: 0	Drawn by: Patrick Redmond
Read in conjunction with associated lighting calculations		
Do not scale from drawing		All dimensions in metres
Document control: TD 09		Version: 1.0
Redmond Analytical Management Services Ltd. Rosewood House, Mount Seaton, Camolin, Enniscorthy, Co. Wexford. Y21 K8P3		
086 2356356	info@redmondams.ie	www.redmondams.ie



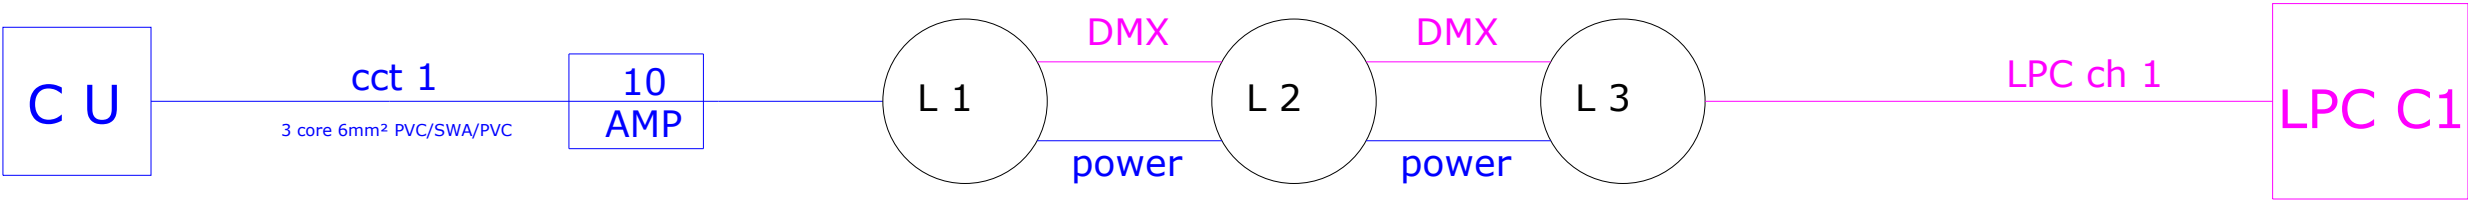

-  Divum 50K. 37lm at 8880K. With internal line of sight WiFi, 4 Gobo rotator wheel, beam shaper and DMX driver. Mounted on Wall brackets between first floor and second floor windows on building opposite. 600W connected load.
-  Cabinet providing power supply and DMX supply to projectors.

Be advised that other services may exist that are not shown on this drawing. This drawing should not be taken as definitive or an indication that it is safe to dig.

Drawing title:
Electrical Schematic ~ As Built

Project title:
Fáilte Ireland Urban Animation ~ Irish Museum of Science & The Storey of Time

Client:
Waterford City & County Council

Project number: 22013	Date: 17/06/2025	Hard copy approved:
Drawing number: 22013 - 2A	Revision: 0	Drawn by: Patrick Redmond

Read in conjunction with associated lighting calculations
Do not scale from drawing All dimensions in metres
Document control: TD 09 Version: 1.0

Redmond Analytical Management Services Ltd.
Rosewood House, Mount Seaton, Camolin, Enniscorthy, Co. Wexford. Y21 K8P3
086 2356356 info@redmondams.ie www.redmondams.ie



MSLL ~ Society of Light and Lighting

MILP ~ Institution of Lighting Professionals

