


Bollards

LS

Mh

38


STREET

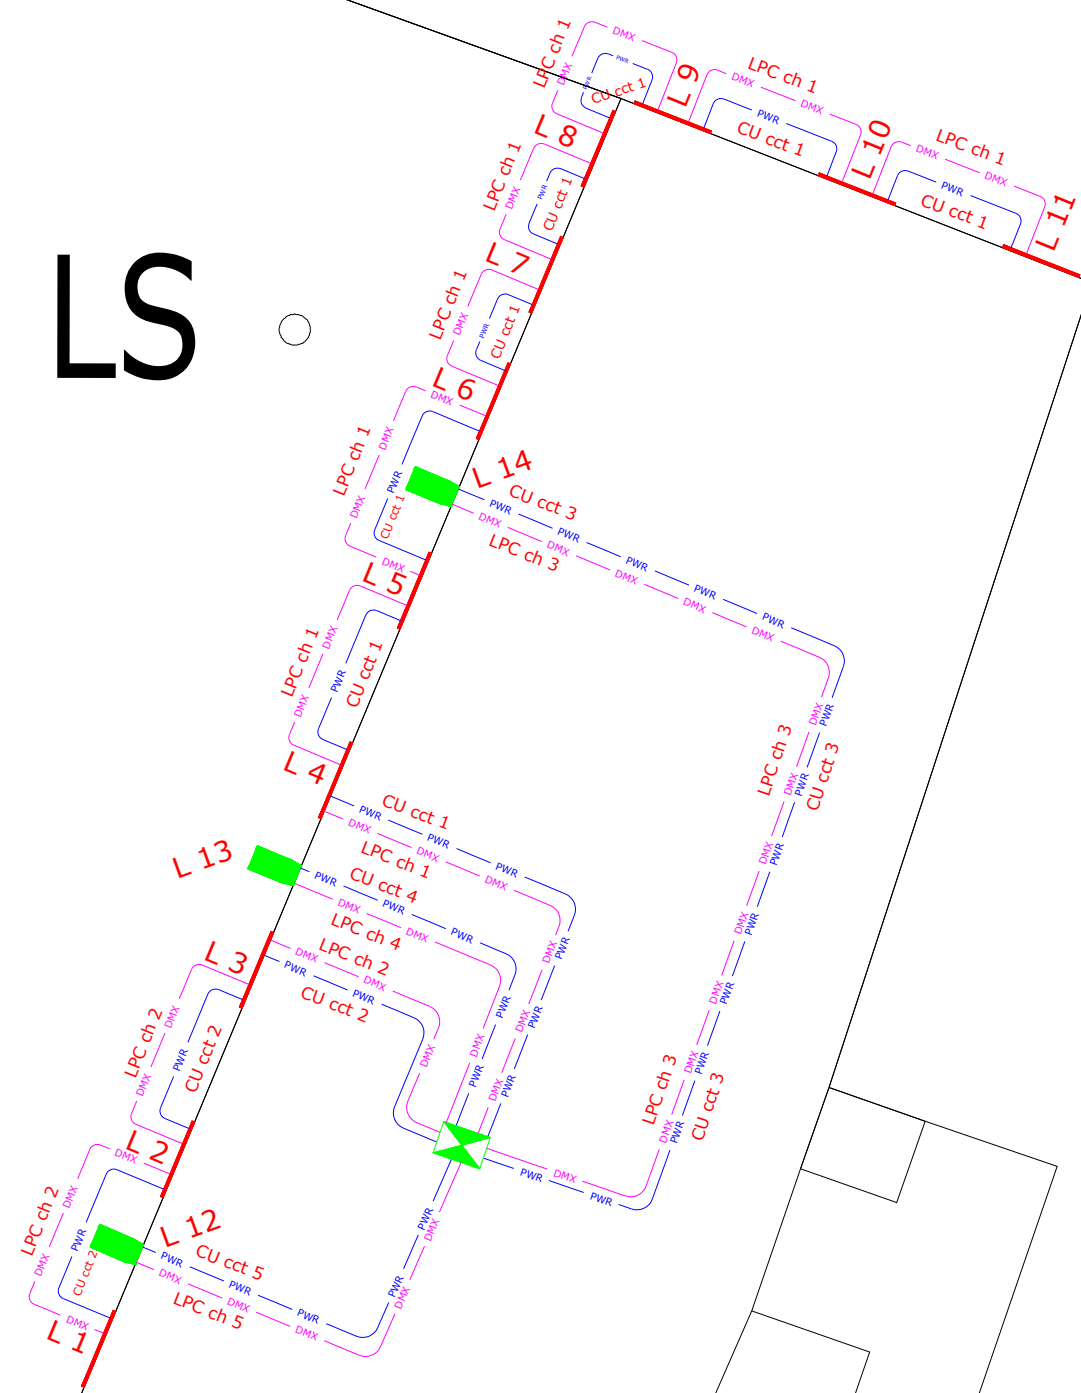

- Urbis Sculpture S100 6291 RGBW diffuser P25 striated 40 Oscon SSL 150 350mA. 346982. Complete with mounting kit and embellishment plate. Mounted on adjustable brackets, on wall, under eaves. To be fixed using chemical anchors only. 50W connected load at maximum output.
 - Divum 50K. 37lm at 8880K. With internal line of sight WiFi, 4 GOBO rotator wheel, dynamic effect wheel, beam shaper and DMX driver. Mounted on wall, under eaves, aimed towards street. 600W connected load.
 - Urbis Lighting Playback Controller, and Urbis Cellular Router to be installed close to the consumer unit within the building.
- Contractor will be required to find appropriate routing for cables within the building.
- All cables to be installed and connections made in accordance with I.S. 10101: Latest version.

Be advised that other services may exist that are not shown on this drawing. This drawing should not be taken as definitive or an indication that it is safe to dig.		
Drawing title: Illumination Layout ~ As Built		
Project title: Fáilte Ireland Urban Animation ~ Former Munster Express Building		
Client: Waterford City & County Council		
Project number: 22014	Date: 17/06/2025	Hard copy approved:
Drawing number: 22014 - 1A	Revision: 0	Drawn by: Patrick Redmond
Read in conjunction with associated lighting calculations		
Do not scale from drawing		All dimensions in metres
Document control: TD 09		Version: 1.0
Redmond Analytical Management Services Ltd. Rosewood House, Mount Seaton, Camolin, Enniscorthy, Co. Wexford. Y21 K8P3 086 2356356 info@redmondams.ie www.redmondams.ie		



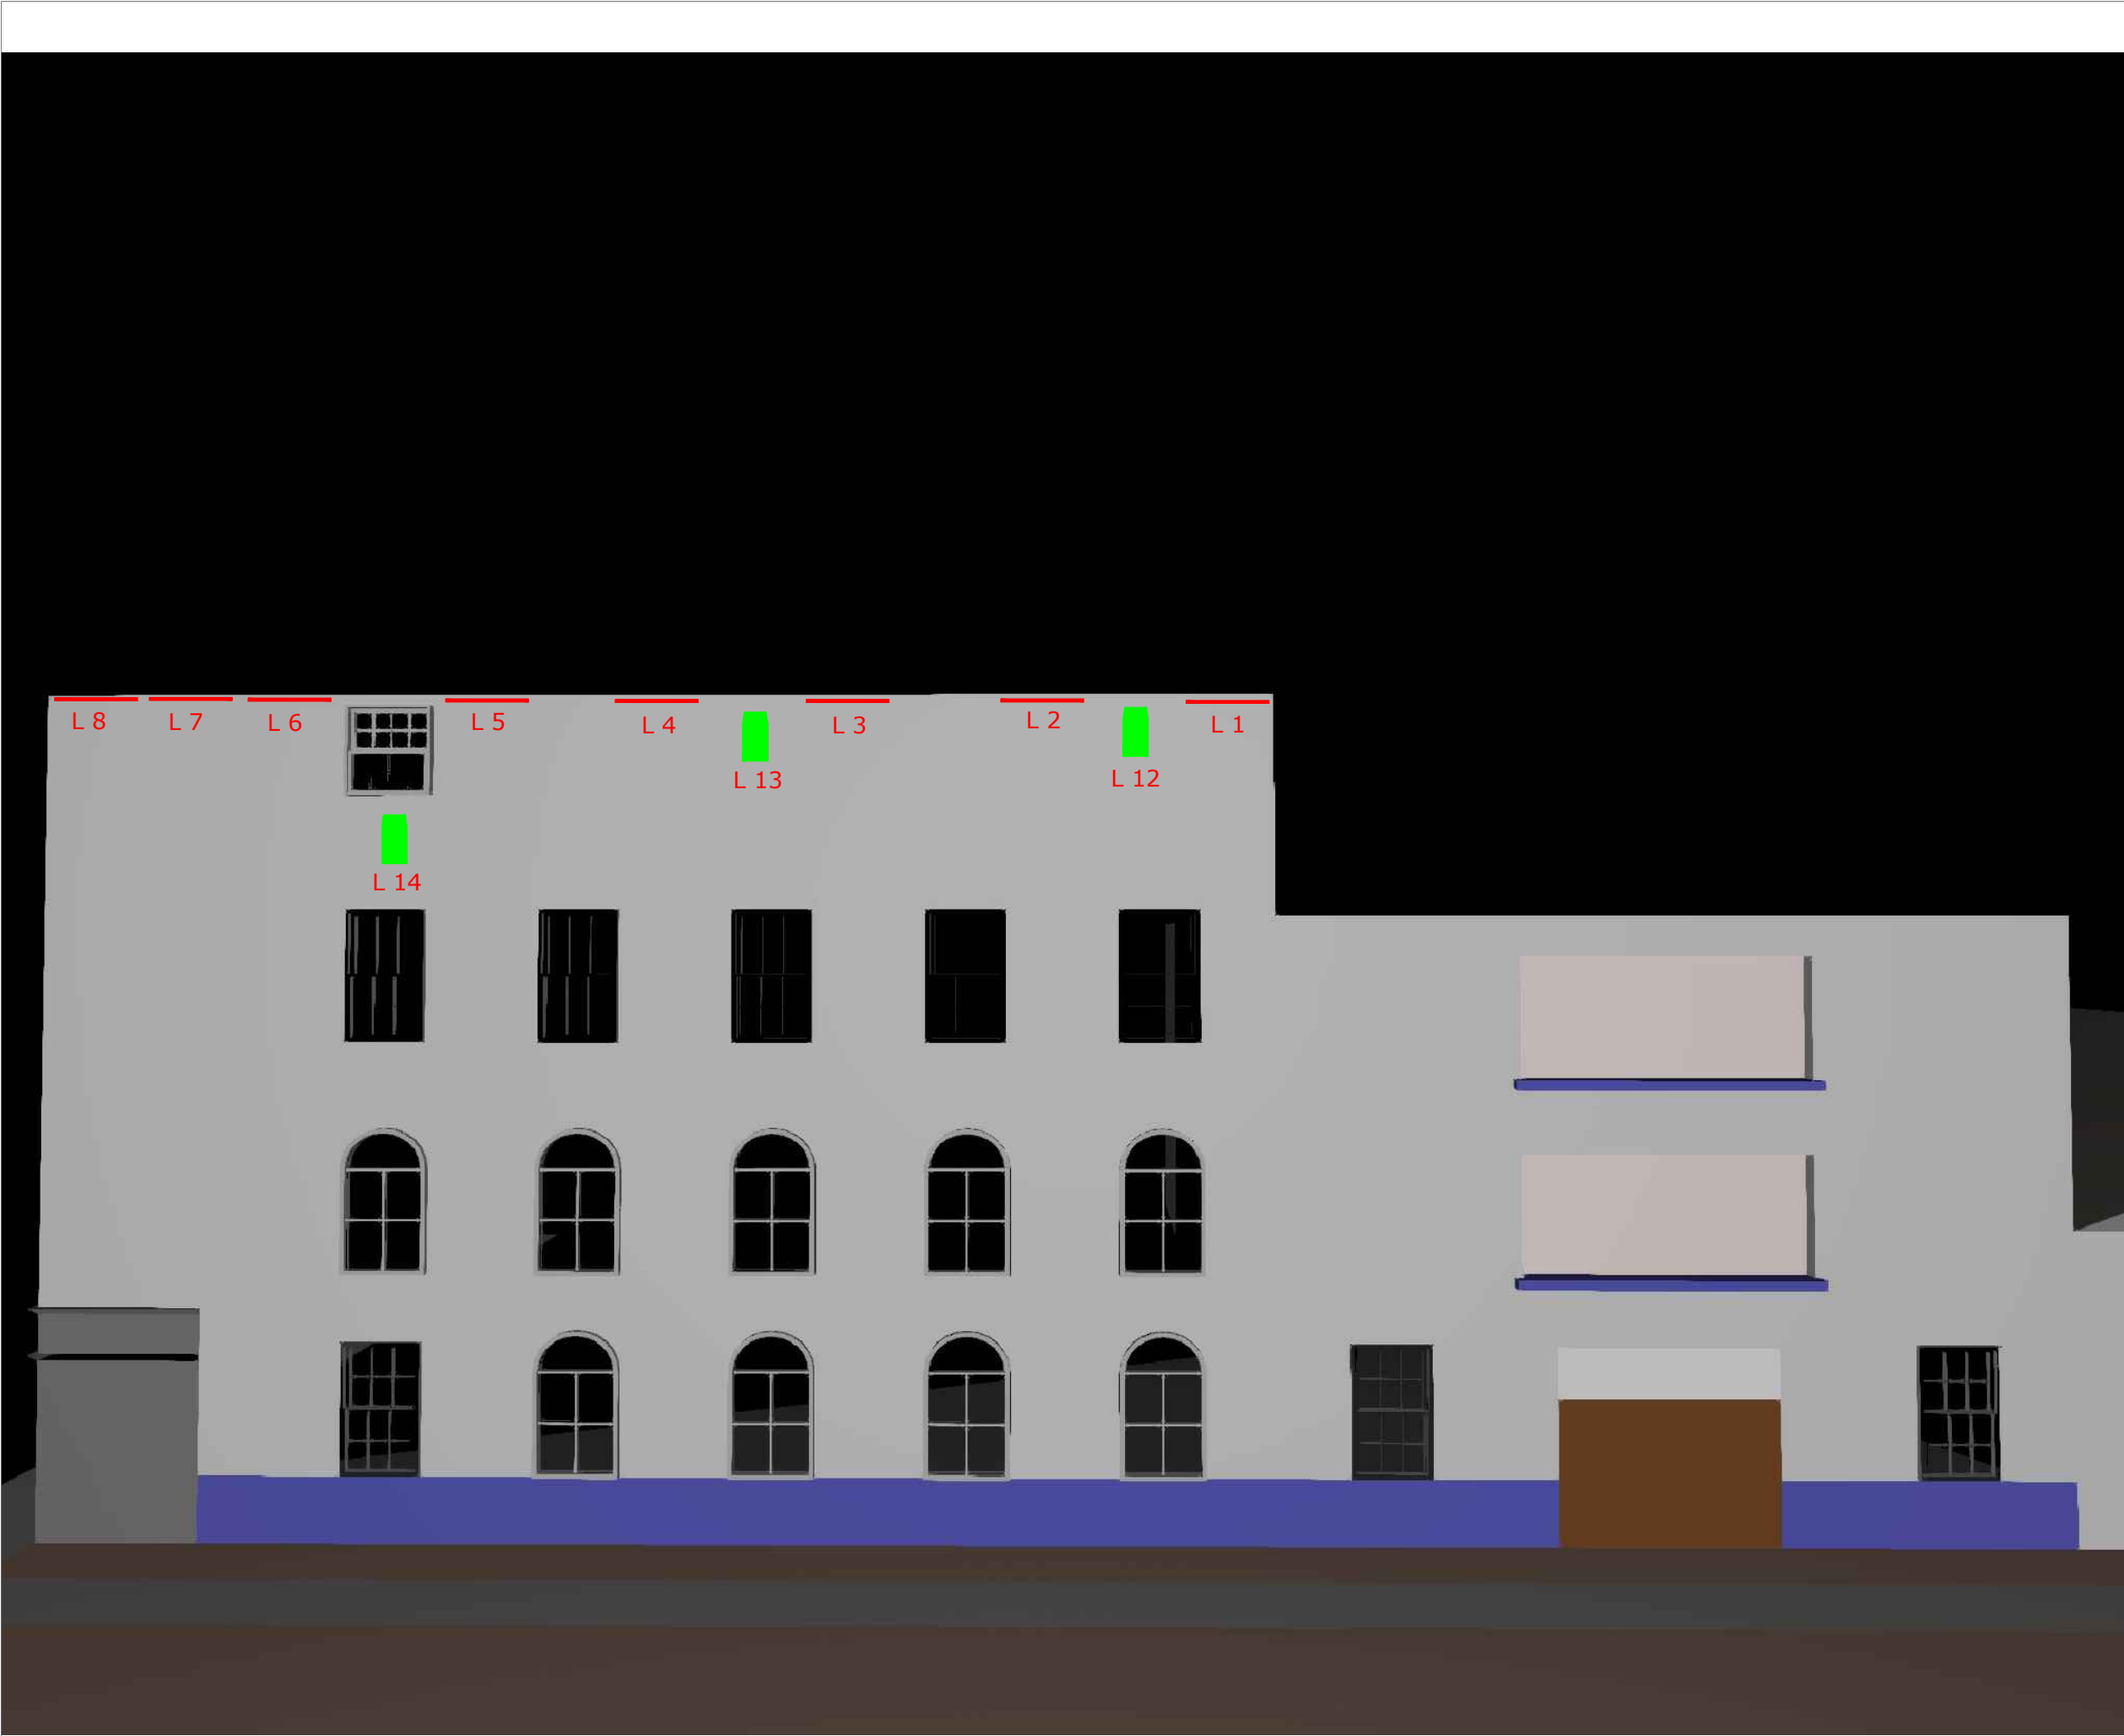

© COPYRIGHT RESERVED (Redmond AMS Ltd.)

Urbis Sculptline S100 6291 RGBW diffuser P25 striated 40 Oslon SSL 150 350mA. 346982. Complete with mounting kit and embellishment plate. Mounted on adjustable brackets, on wall, under eaves. To be fixed using chemical anchors only. 50W connected load at maximum output.

Divum 50K. 37lm at 8880K. With internal line of sight WiFi, 4 GOBO rotator wheel, dynamic effect wheel, beam shaper and DMX driver. Mounted on wall, under eaves, aimed towards street. 600W connected load.

Urbis Lighting Playback Controller, and Urbis Cellular Router to be installed close to the consumer unit within the building.
Contractor will be required to find appropriate routing for cables within the building.
All cables to be installed and connections made in accordance with I.S. 10101: Latest version.

Be advised that other services may exist that are not shown on this drawing. This drawing should not be taken as definitive or an indication that it is safe to dig.

Drawing title:
Illumination Layout ~ As Built

Project title:
Fáilte Ireland Urban Animation ~ Former Munster Express Building

Client:
Waterford City & County Council

Project number: 22014	Date: 17/06/2025	Hard copy approved:
Drawing number: 22014 - 2A	Revision: 0	Drawn by: Patrick Redmond

Read in conjunction with associated lighting calculations

Do not scale from drawing

All dimensions in metres

Document control: TD 09

Version: 1.0

Redmond Analytical Management Services Ltd.
Rosewood House, Mount Seaton, Camolin, Enniscorthy, Co. Wexford. Y21 K8P3
086 2356356 | info@redmondams.ie | www.redmondams.ie




ANALYTICAL MANAGEMENT SERVICES
LIGHTING | ENERGY | DESIGN | SUPPORT

MSLL ~ Society of Light and Lighting

MILP ~ Institution of Lighting Professionals



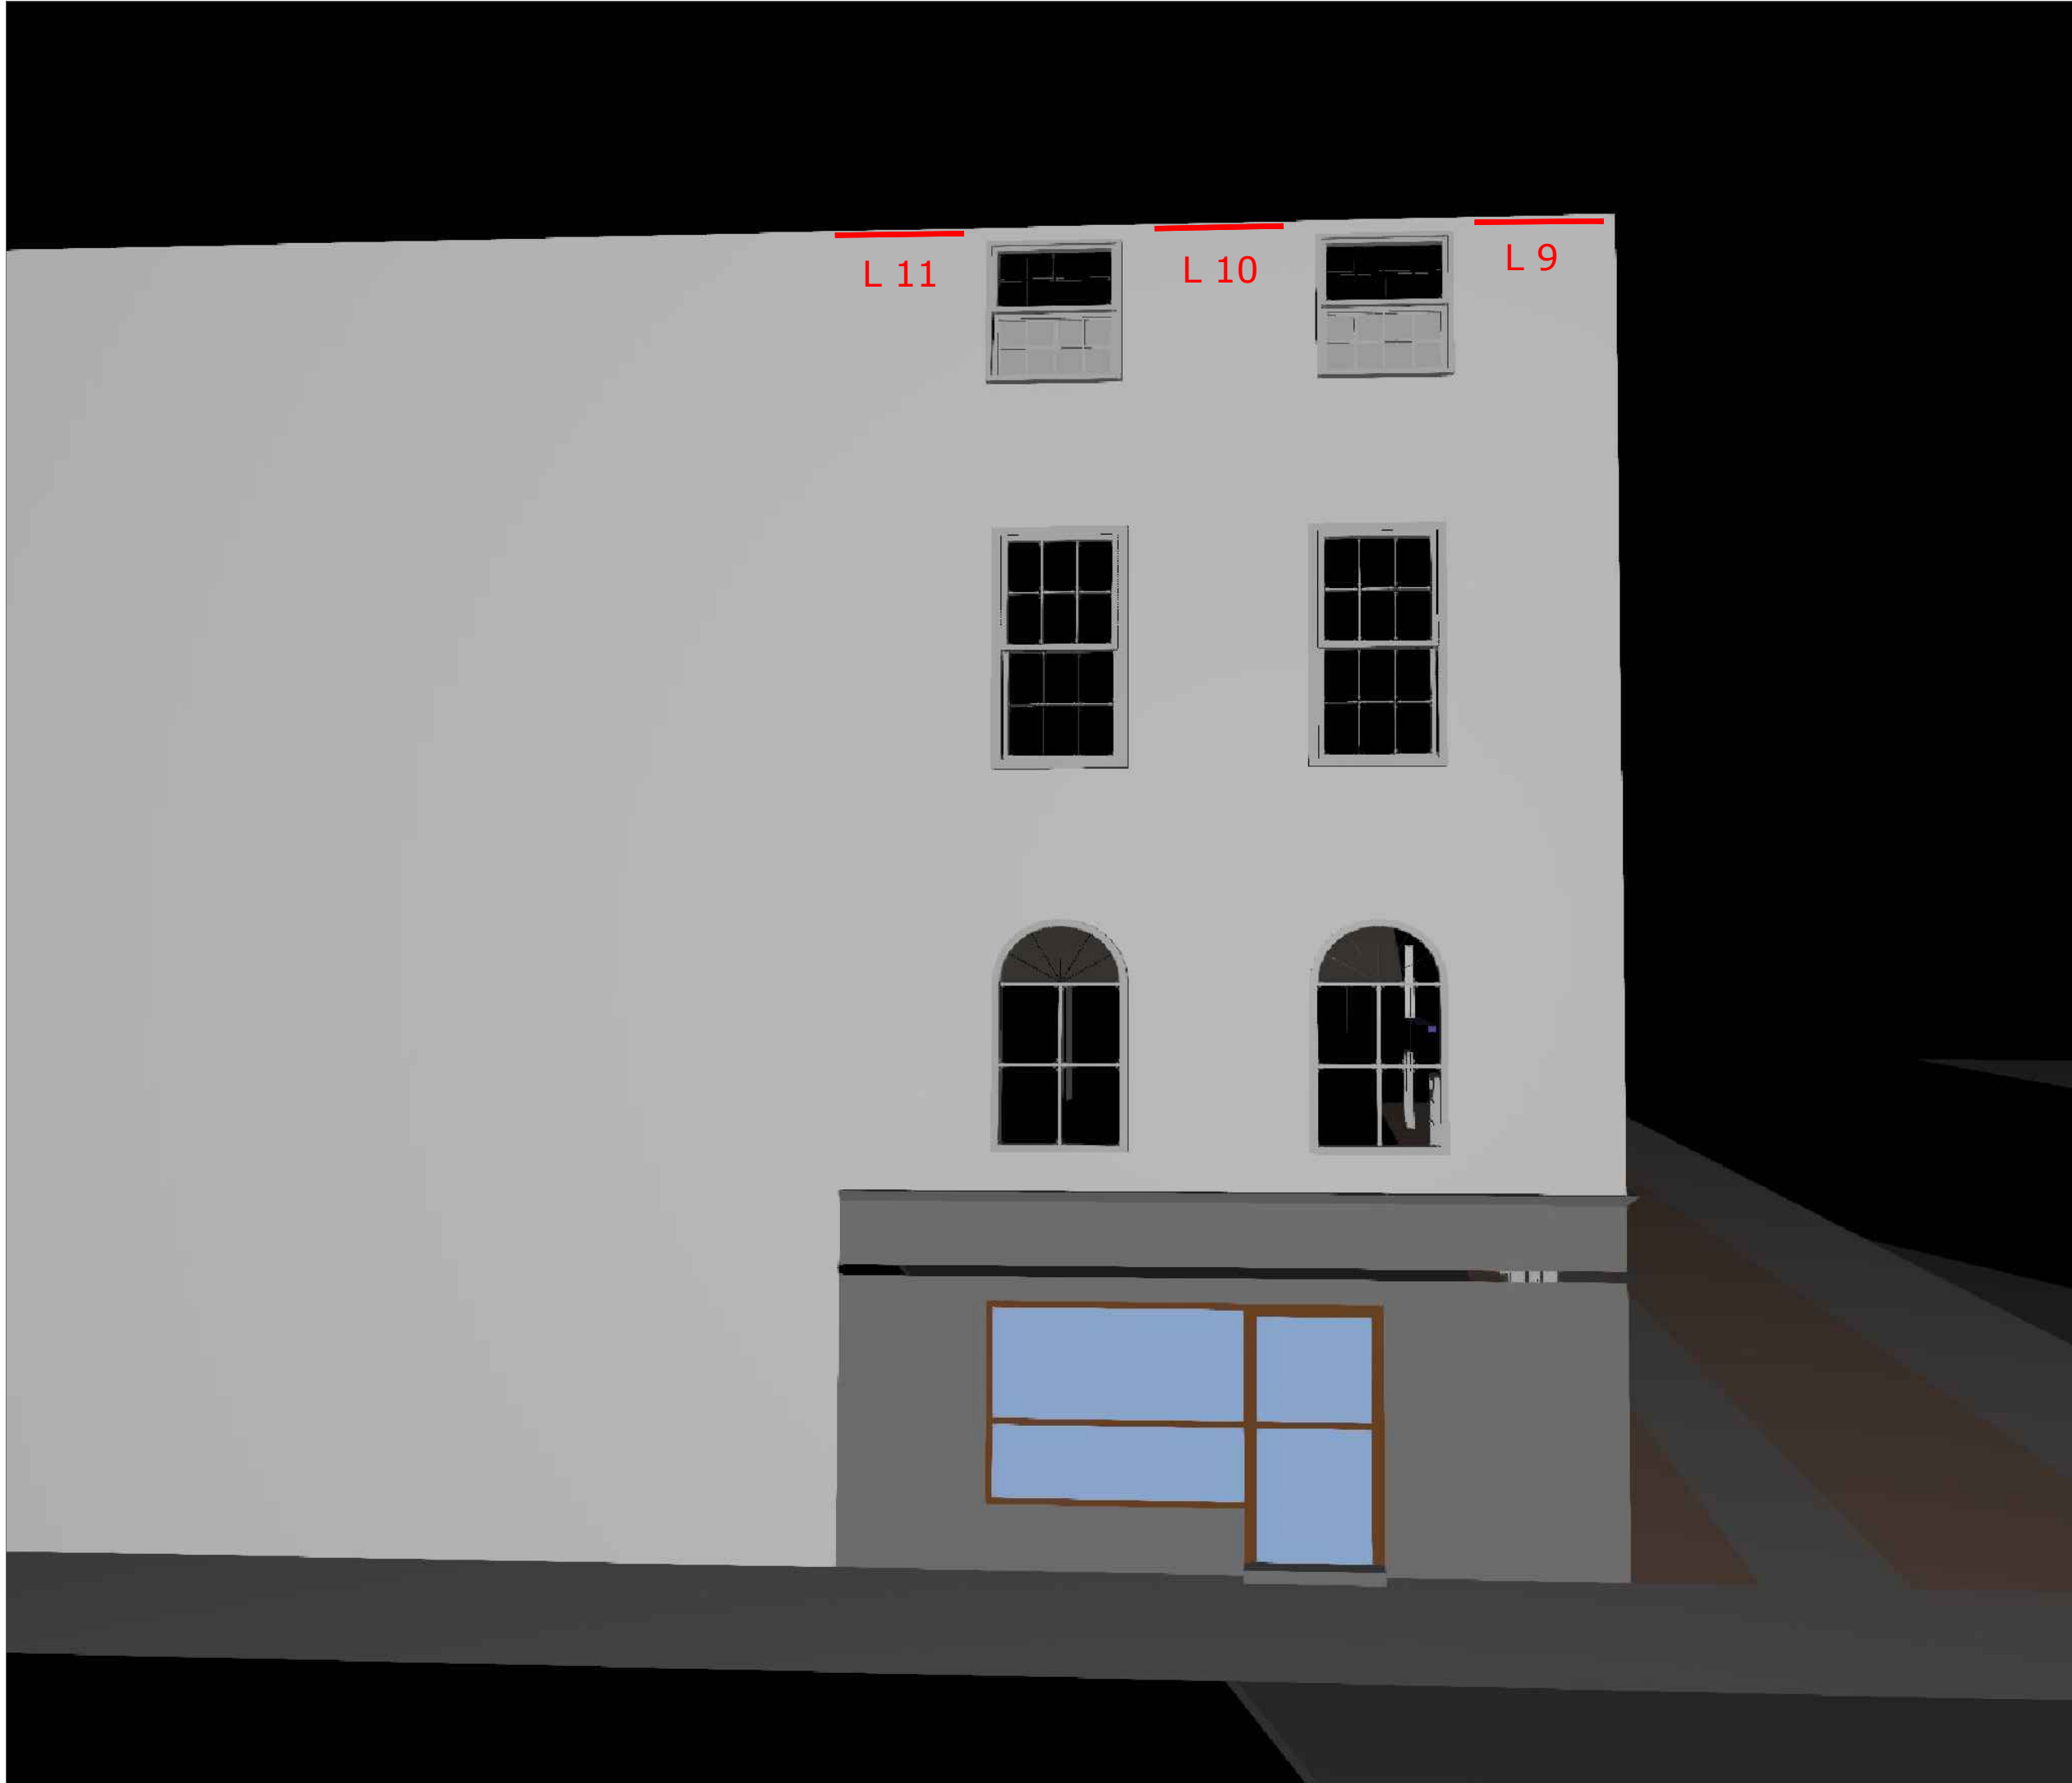

Urbis Sculpture S100 6291 RGBW diffuser P25 striated 40 Oscon SSL 150 350mA. 346982. Complete with mounting kit and embellishment plate. Mounted on adjustable brackets, on wall, under eaves. To be fixed using chemical anchors only. 50W connected load at maximum output.

Divum 50K. 37lm at 8880K. With internal line of sight WiFi, 4 GOBO rotator wheel, dynamic effect wheel, beam shaper and DMX driver. Mounted on wall, under eaves, aimed towards street. 600W connected load.

Urbis Lighting Playback Controller, and Urbis Cellular Router to be installed close to the consumer unit within the building.

Contractor will be required to find appropriate routing for cables within the building.

All cables to be installed and connections made in accordance with I.S. 10101: Latest version.

Be advised that other services may exist that are not shown on this drawing. This drawing should not be taken as definitive or an indication that it is safe to dig.

Drawing title:
Illumination Layout ~ As Built

Project title:
Fáilte Ireland Urban Animation ~ Former Munster Express Building

Client:
Waterford City & County Council

Project number: 22014	Date: 17/06/2025	Hard copy approved:
Drawing number: 22014 - 3A	Revision: 0	Drawn by: Patrick Redmond

Read in conjunction with associated lighting calculations	
Do not scale from drawing	All dimensions in metres
Document control: TD 09	Version: 1.0

Redmond Analytical Management Services Ltd.
Rosewood House, Mount Seaton, Camolin, Enniscorthy, Co. Wexford. Y21 K8P3
086 2356356 | info@redmondams.ie | www.redmondams.ie



MSLL ~ Society of Light and Lighting

MILP ~ Institution of Lighting Professionals




Urbis Sculpture S100 6291 RGBW diffuser P25 striated 40 Oscon SSL 150 350mA. 346982. Complete with mounting kit and embellishment plate. Mounted on adjustable brackets, on wall, under eaves. To be fixed using chemical anchors only. 50W connected load at maximum output.

Divum 50K. 37lm at 8880K. With internal line of sight WiFi, 4 GOBO rotator wheel, dynamic effect wheel, beam shaper and DMX driver. Mounted on wall, under eaves, aimed towards street. 600W connected load.

Urbis Lighting Playback Controller, and Urbis Cellular Router to be installed close to the consumer unit within the building.

Contractor will be required to find appropriate routing for cables within the building.

All cables to be installed and connections made in accordance with I.S. 10101: Latest version.

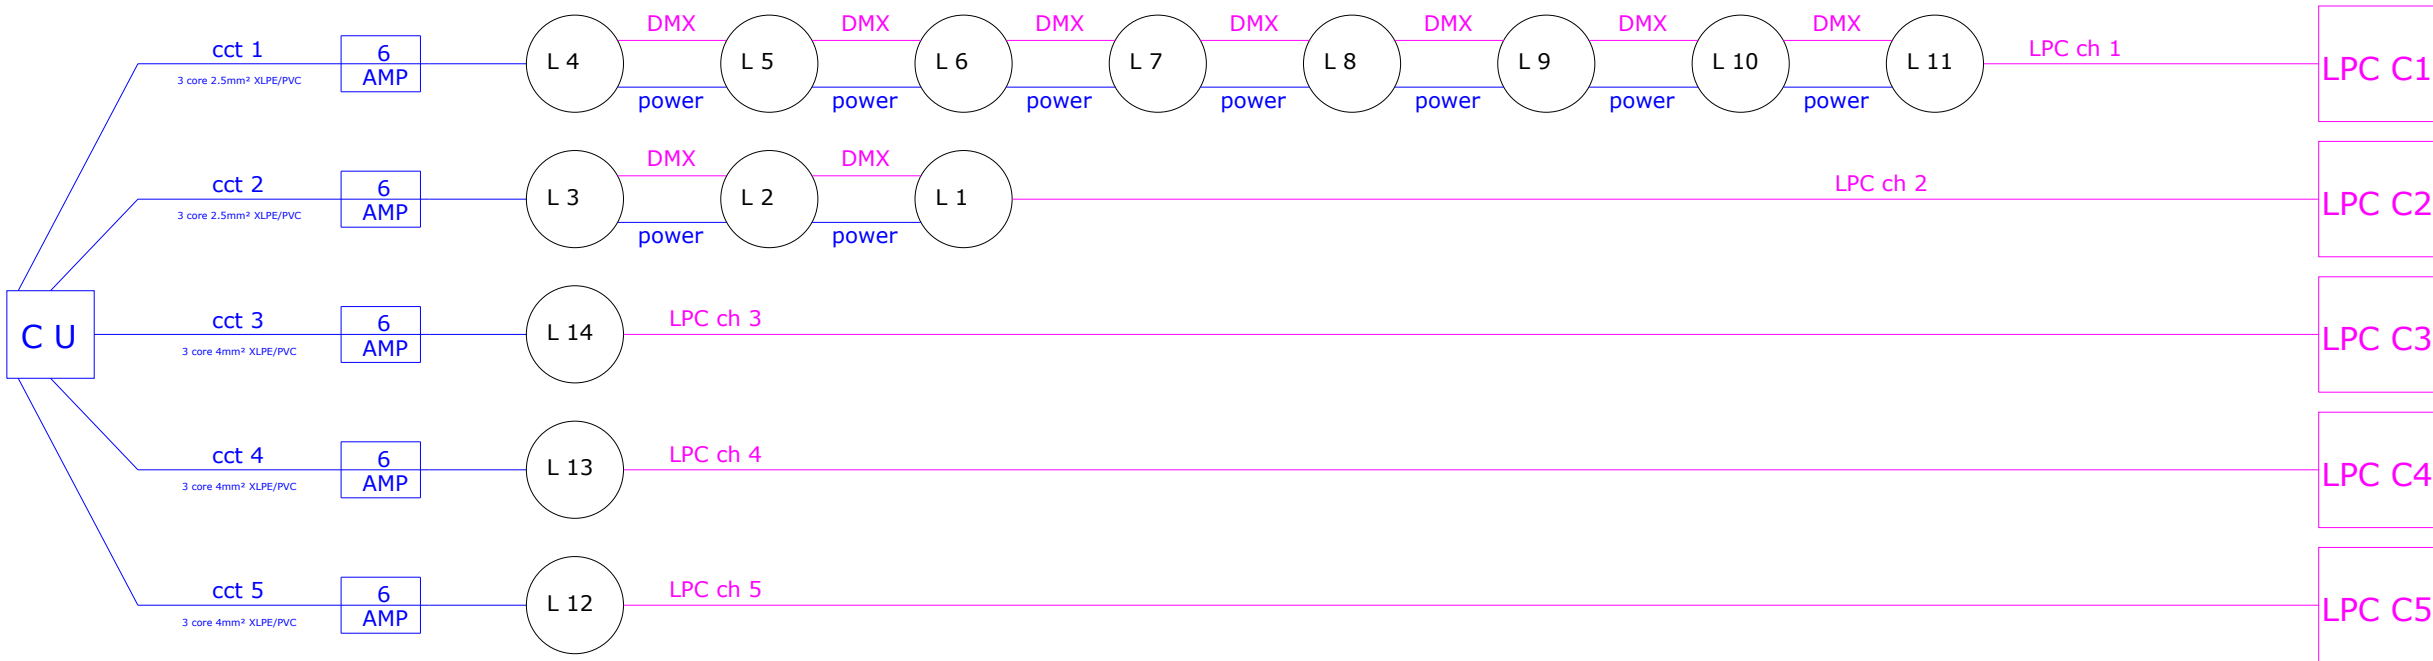

Be advised that other services may exist that are not shown on this drawing. This drawing should not be taken as definitive or an indication that it is safe to dig.

Drawing title:
Electrical Schematic ~ As Built

Project title:
Fáilte Ireland Urban Animation ~ Former Munster Express Building

Client:
Waterford City & County Council

Project number: 22014	Date: 17/06/2025	Hard copy approved:
Drawing number: 22014 - 4A	Revision: 0	Drawn by: Patrick Redmond

Read in conjunction with associated lighting calculations

Do not scale from drawing All dimensions in metres

Document control: TD 09 Version: 1.0

Redmond Analytical Management Services Ltd.
Rosewood House, Mount Seaton, Camolin, Enniscorthy, Co. Wexford. Y21 K8P3
086 2356356 info@redmondams.ie www.redmondams.ie



MSLL ~ Society of Light and Lighting

MILP ~ Institution of Lighting Professionals

