


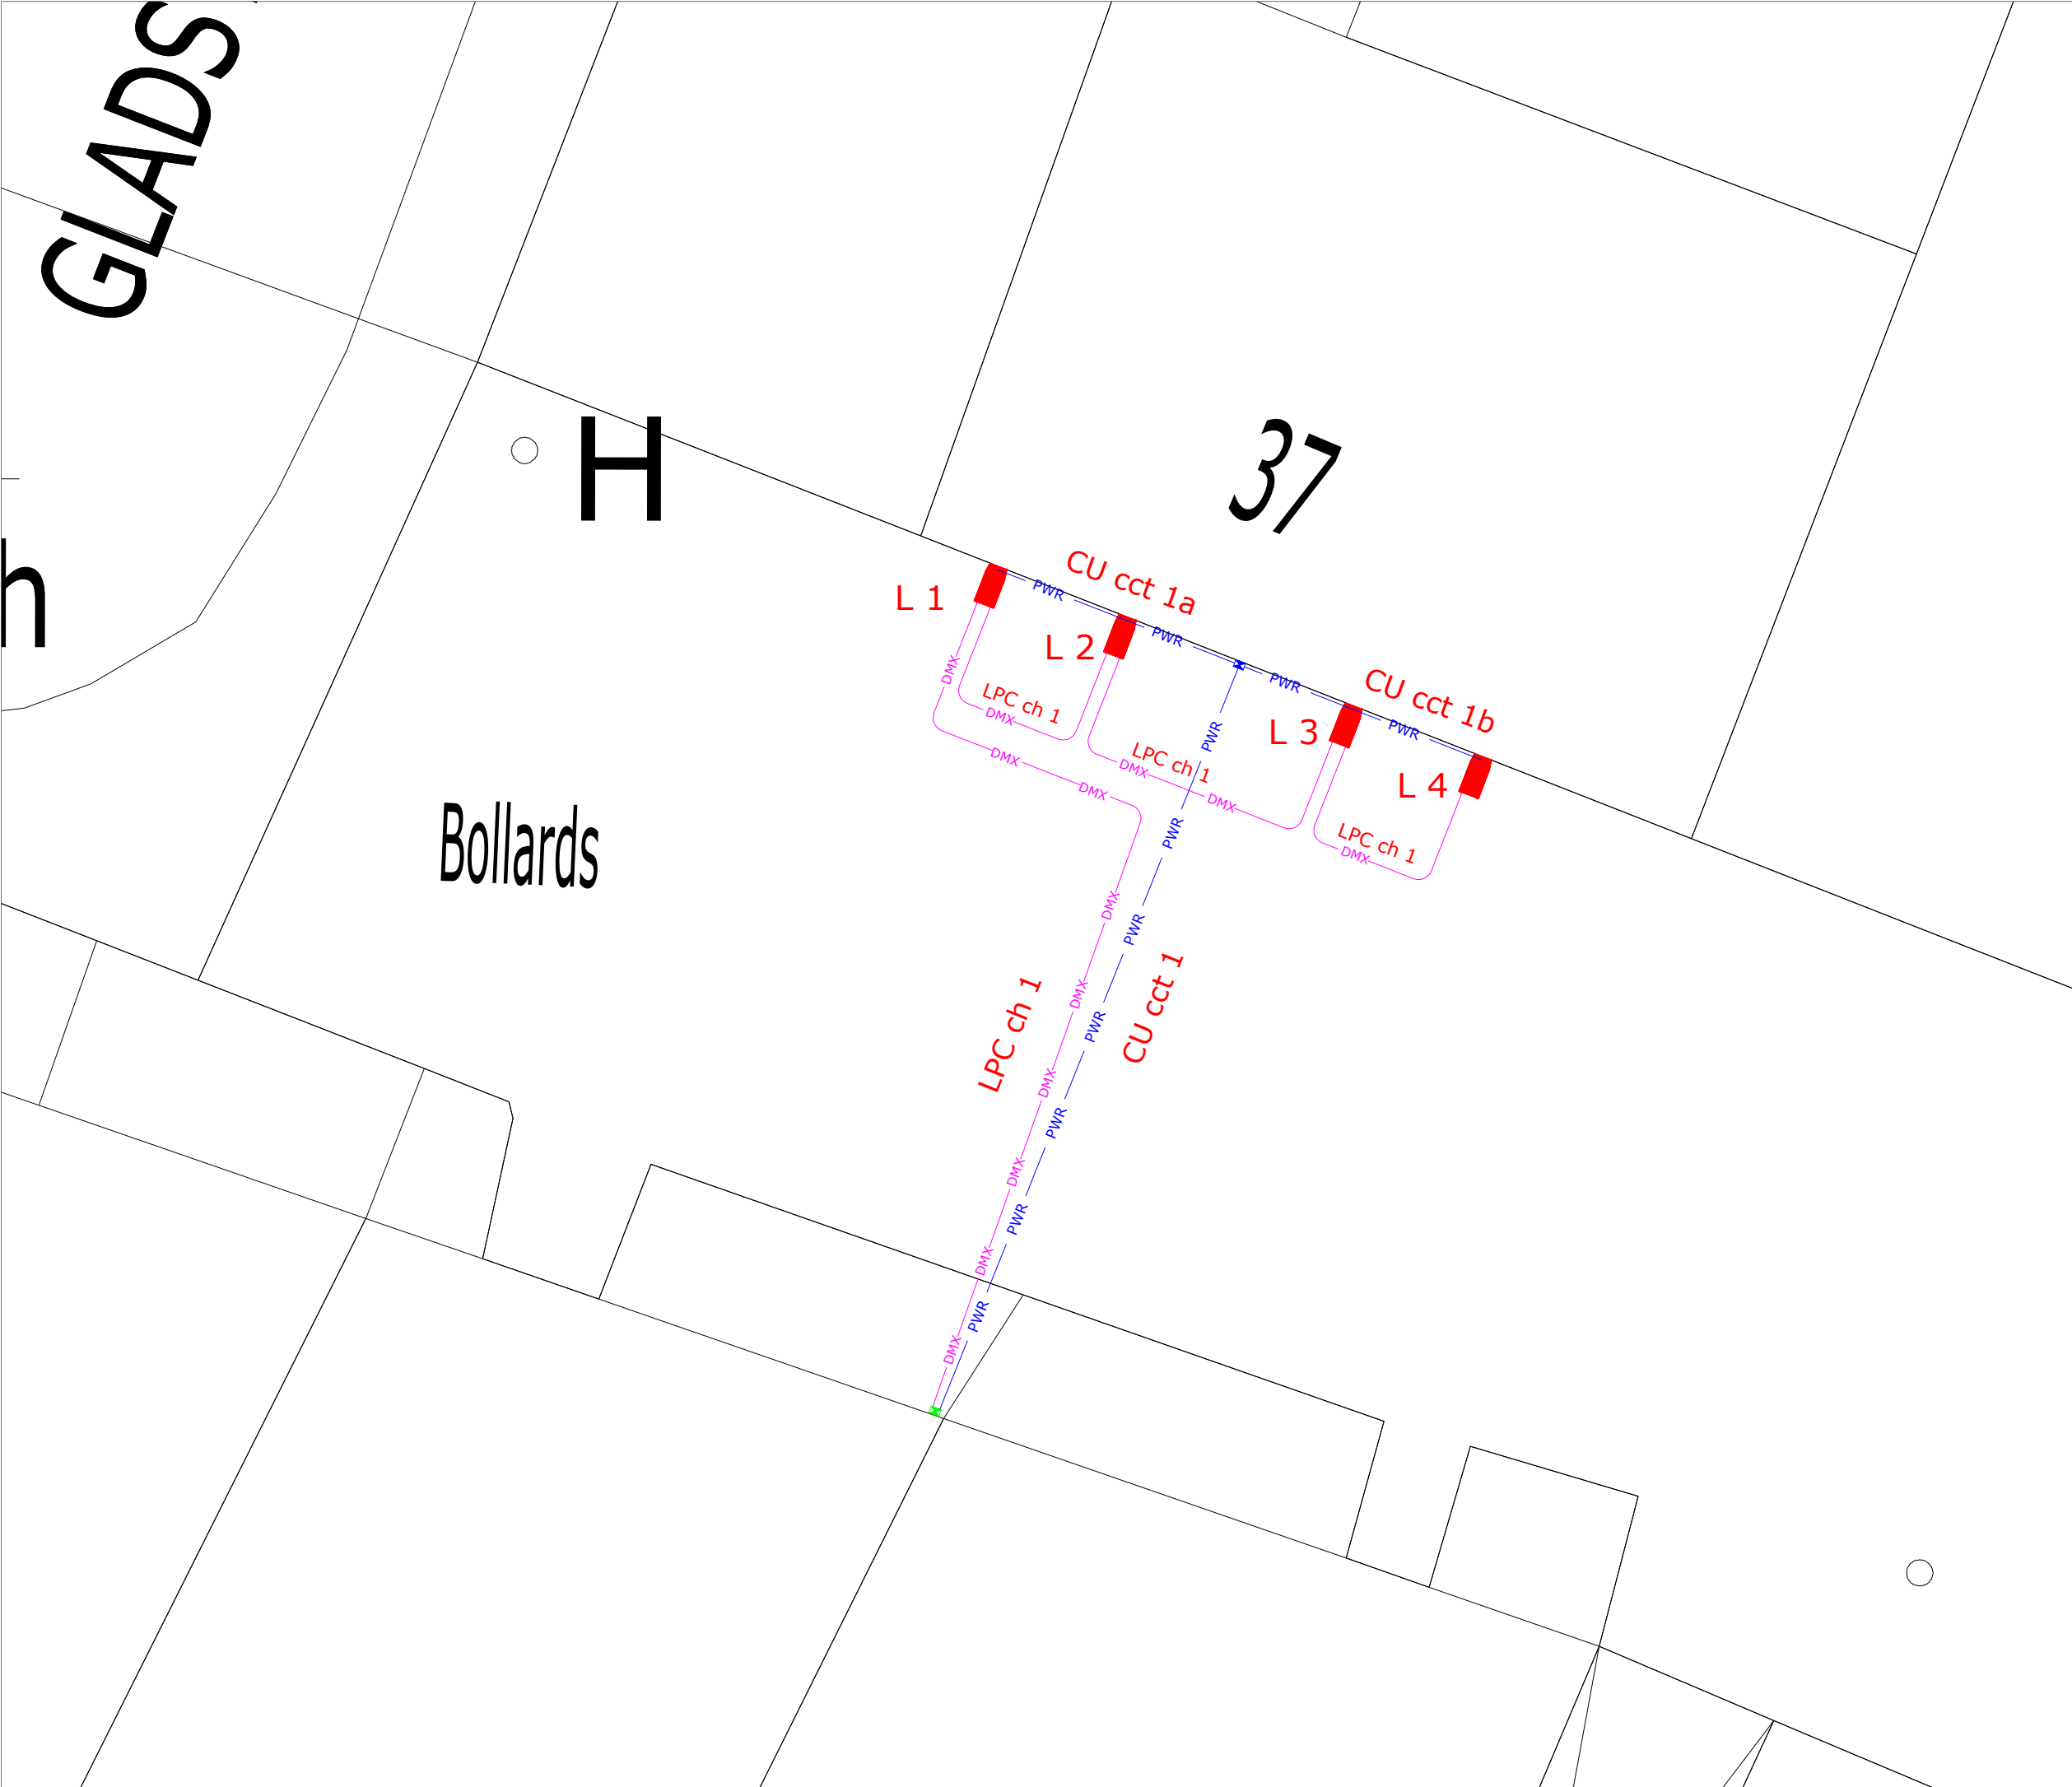

© COPYRIGHT RESERVED (Redmond AMS Ltd.)

Divum 50K. 37lm at 8880K. With internal line of sight WiFi, 4 Gobo rotator wheel, dynamic effect wheel, beam shaper and DMX driver. Mounted on Wall brackets between second floor and third floor windows on building opposite. 600W connected load. Note that the locations shown are not accurate, rather are for information.

IP66 enclosure large enough to accommodate fixings to split power cable into two circuits. Mounted on wall.

Urbis Lighting Playback Controller, Urbis DMX Splitter, and Urbis Cellular Router to be installed close to the consumer unit within the building. Contractor will be required to find appropriate routing for cables within the building.

All cables to be laid in accordance with Waterford City & County Council specifications and I.S. 10101: Latest version.

Be advised that other services may exist that are not shown on this drawing. This drawing should not be taken as definitive or an indication that it is safe to dig.

Drawing title:

illumination Layout ~ As Built

Project title:

Fáilte Ireland Urban Animation ~ Presbytery

Client:

Waterford City & County Council

Project number:

22015

Drawing number:

22015 - 1A

Date:

12/07/2025

Revision:

0

Hard copy approved:

Drawn by:

Patrick Redmond

Read in conjunction with associated lighting calculations

Do not scale from drawing

All dimensions in metres

Document control: TD 09

Version: 1.0

Redmond Analytical Management Services Ltd.

Rosewood House, Mount Seaton, Camolin, Enniscorthy, Co. Wexford. Y21 K8P3

086 2356356

info@redmondams.ie

www.redmondams.ie

REDMOND


ANALYTICAL MANAGEMENT SERVICES

LIGHTING | ENERGY | DESIGN | SUPPORT

MSLL ~ Society of Light and Lighting

MILP ~ Institution of Lighting Professionals

ILP

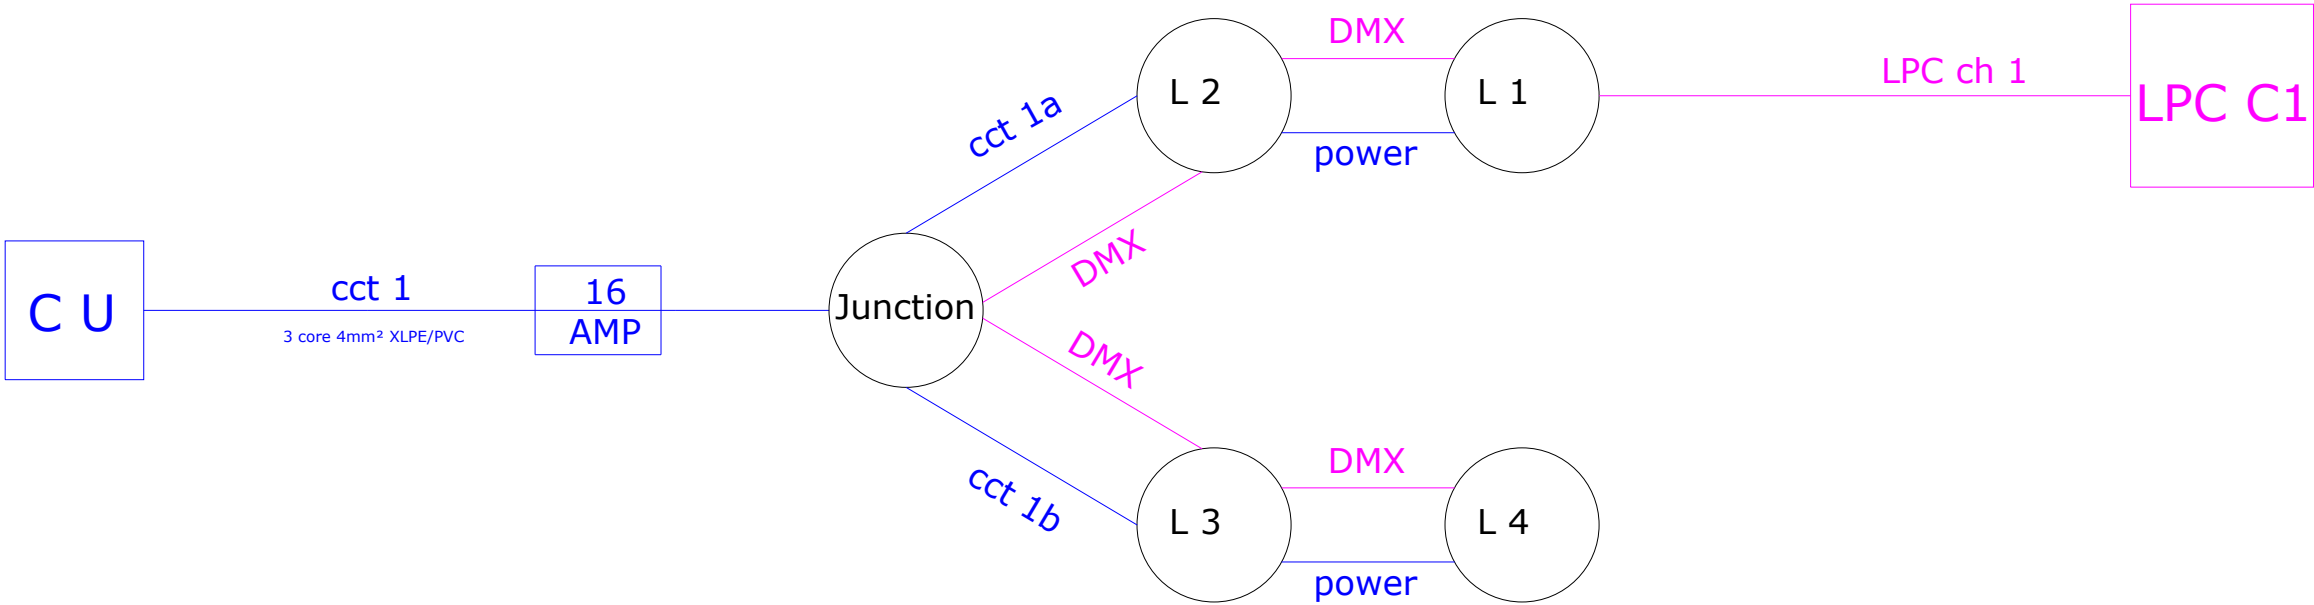

Divum 50K. 37lm at 8880K. With internal line of sight WiFi, 4 Gobo rotator wheel, dynamic effect wheel, beam shaper and DMX driver. Mounted on Wall brackets between second floor and third floor windows on building opposite. 600W connected load. Note that the locations shown are not accurate, rather are for information.

IP66 enclosure large enough to accommodate fixings to split power cable into two circuits. Mounted on wall.

Urbis Lighting Playback Controller, Urbis DMX Splitter, and Urbis Cellular Router to be installed close to the consumer unit within the building. Contractor will be required to find appropriate routing for cables within the building.

All cables to be laid in accordance with Waterford City & County Council specifications and I.S. 10101: Latest version.

Be advised that other services may exist that are not shown on this drawing. This drawing should not be taken as definitive or an indication that it is safe to dig.

Drawing title: Electrical Schematic ~ As Built		
Project title: Fáilte Ireland Urban Animation ~ Presbytery		
Client: Waterford City & County Council		
Project number: 22015	Date: 12/07/2025	Hard copy approved:
Drawing number: 22015 - 2A	Revision: 0	Drawn by: Patrick Redmond
Read in conjunction with associated lighting calculations		
Do not scale from drawing	All dimensions in metres	
Document control: TD 09	Version: 1.0	
Redmond Analytical Management Services Ltd. Rosewood House, Mount Seaton, Camolin, Enniscorthy, Co. Wexford. Y21 K8P3		
086 2356356	info@redmondams.ie	www.redmondams.ie



MSLL ~ Society of Light and Lighting

MILP ~ Institution of Lighting Professionals

