


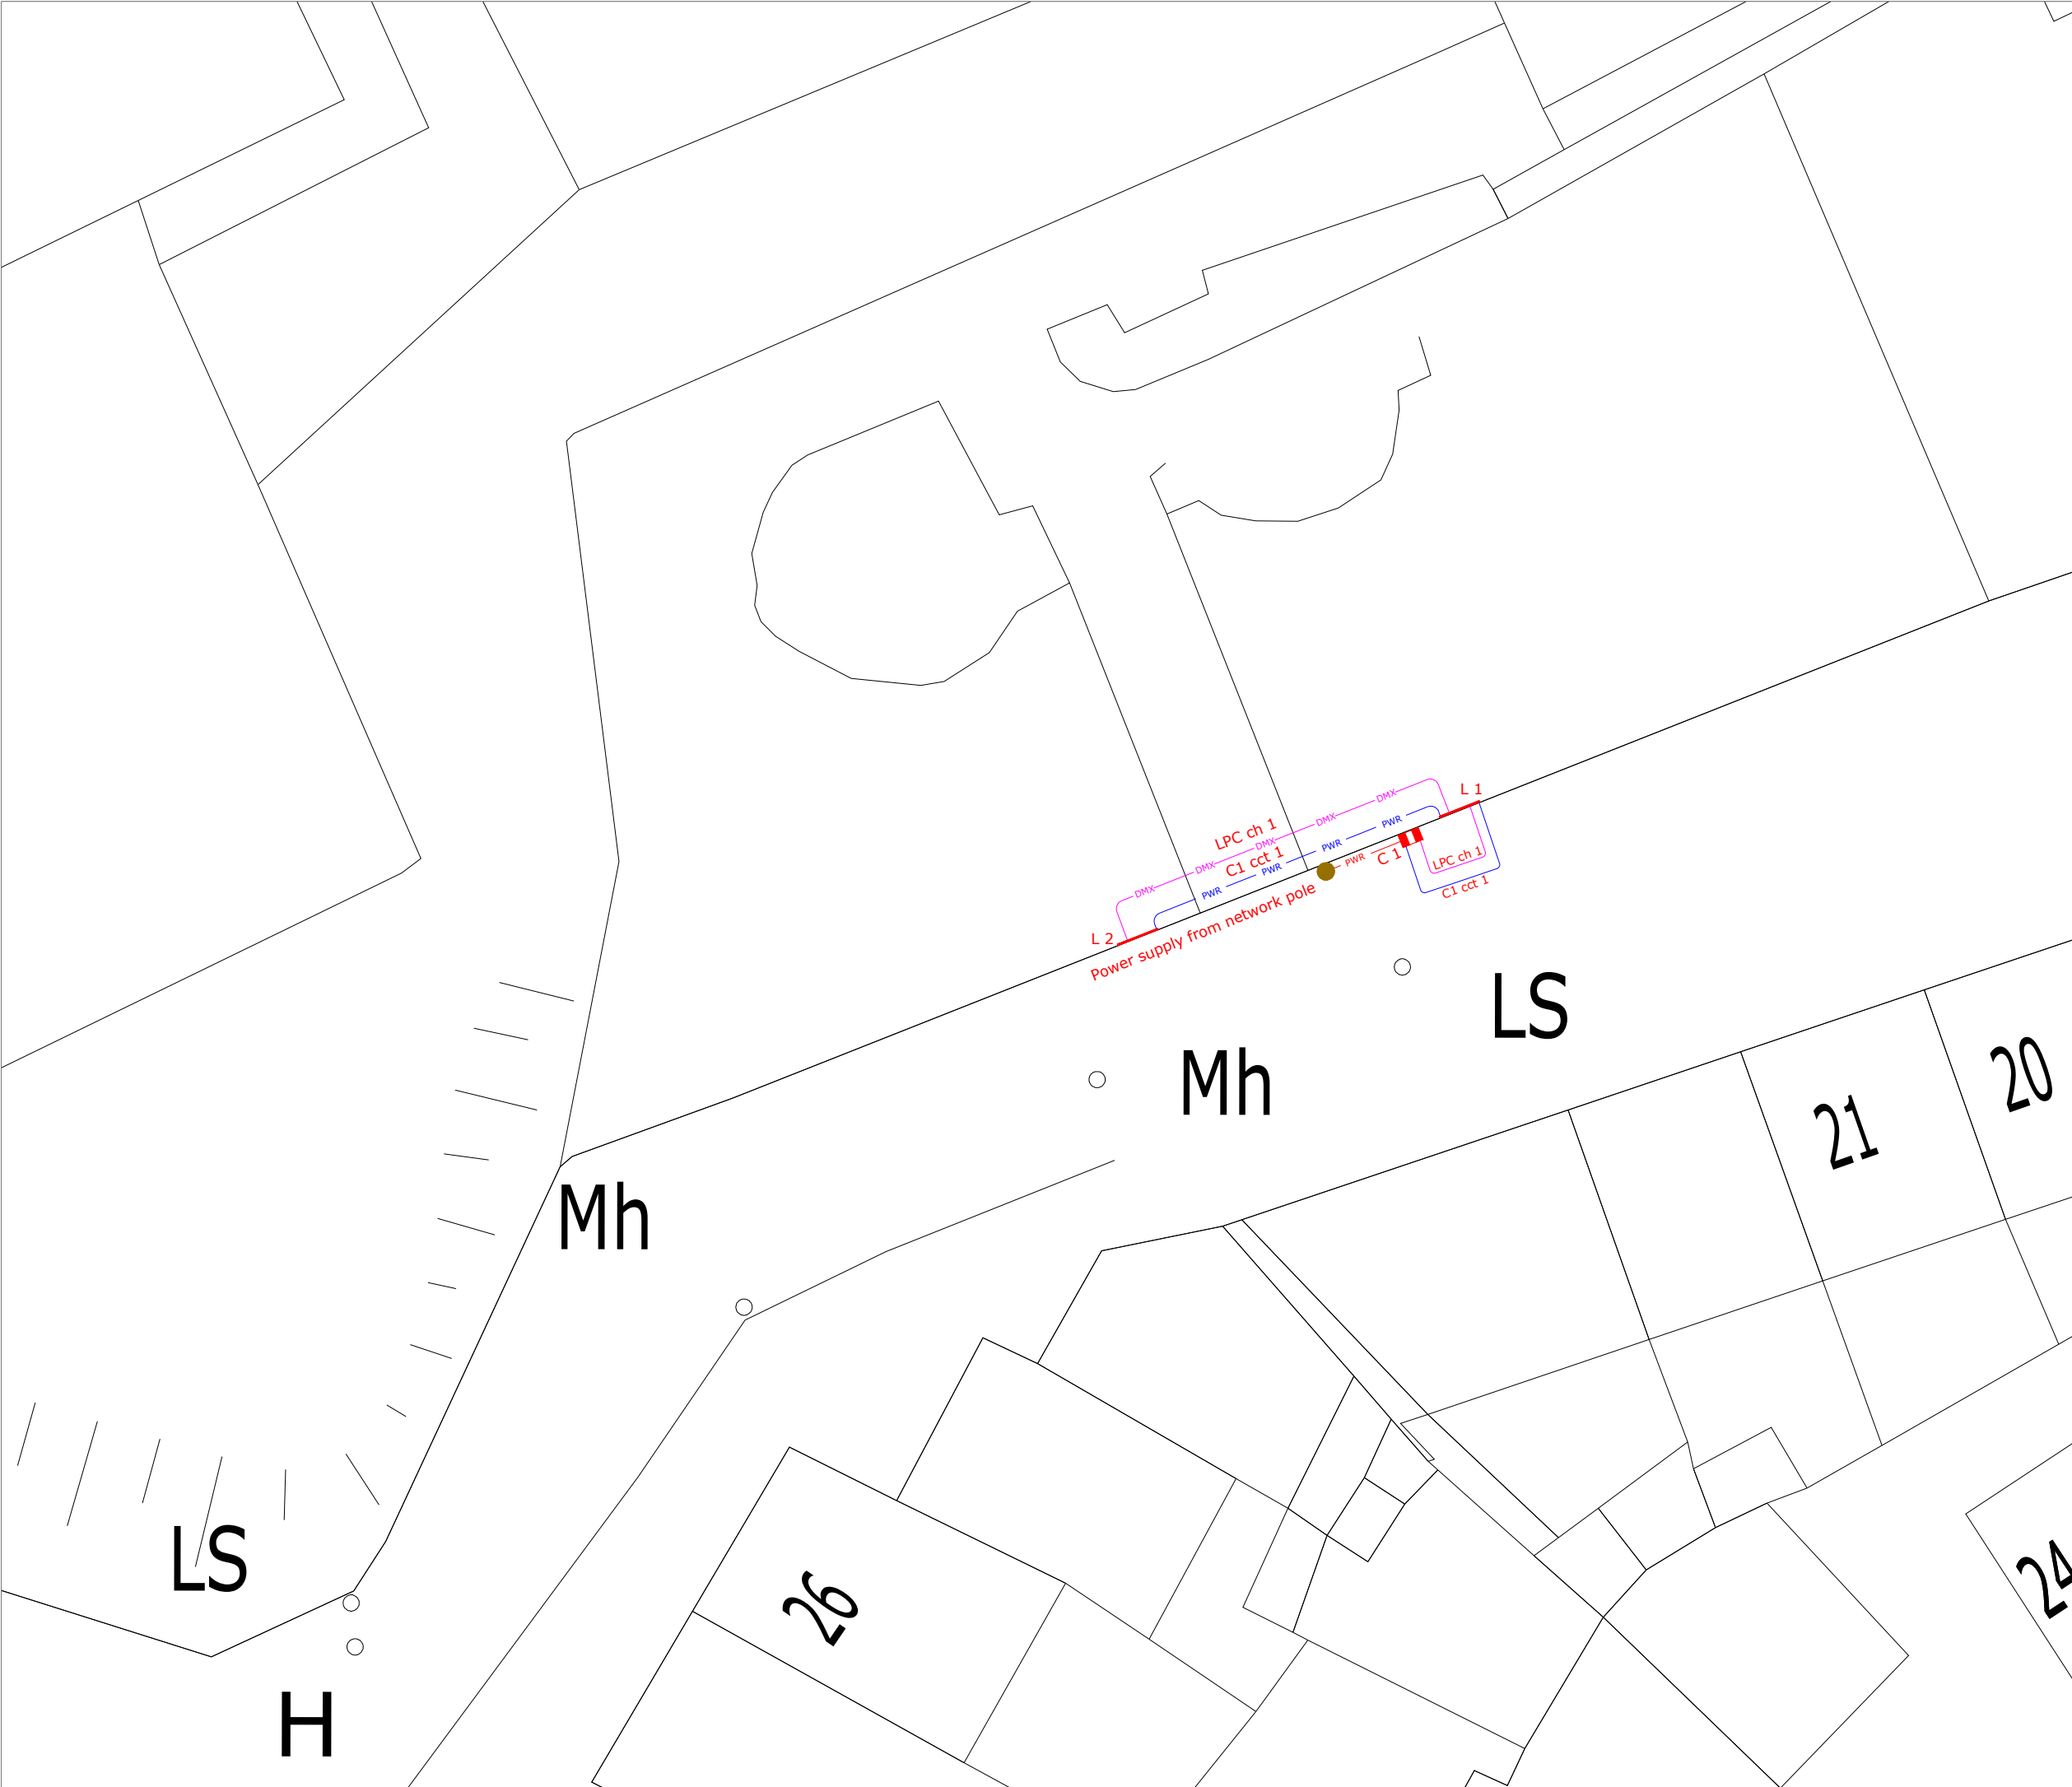

© COPYRIGHT RESERVED (Redmond AMS Ltd.)

Urbis Sculptine S100 6291 RGBW Diffuser P25 striated 40 Oslon SSL 150 350mA 346982, complete with wall mounting kit and embellishment plate. Mounted on adjustable brackets, on wall. 50W connected load at maximum output.

Existing customer service pillar.

Double deck public lighting cabinet with horizontal divide. To house ESN cut out, and isolator in the lower half.

Upper half to house control units, outgoing electrical circuits, and cutouts.

An Urbis Pharos Lighting Playback Controller shall be installed in an IP66 enclosure in the upper section of the cabinet.

An Urbis Cellular Router shall be installed in an IP66 enclosure in hte upper section of the cabinet.

All necessary connections shall be made between the controller and the router.

Ducts and cables to be laid in accordance with Waterford City & County Council specifications and I. S. 10101: Latest version.

9kN draw rope to be provided in each duct.

Excavation can only be undertaken under the supervision of Waterford City & County Council's approved archaeologist.

Be advised that other services may exist that are not shown on this drawing. This drawing should not be taken as definitive or an indication that it is safe to dig.

Drawing title:

As Built Illumination Layout

Project title:

Fáilte Ireland Urban Animation ~ St. Martin's Gate

Client:

Waterford City & County Council

Project number:

22017

Date:

08/06/2025

Hard copy approved:

Drawing number:

22017 - 1A

Revision:

0

Drawn by:

Patrick Redmond

Read in conjunction with associated lighting calculations

Do not scale from drawing

All dimensions in metres

Document control: TD 09

Version: 1.0

Redmond Analytical Management Services Ltd.

Rosewood House, Mount Seaton, Camolin, Enniscorthy, Co. Wexford. Y21 K8P3

086 2356356 | info@redmondams.ie | www.redmondams.ie


MSLL ~ Society of Light and Lighting

MILP ~ Institution of Lighting Professionals

REDMOND

ANALYTICAL MANAGEMENT SERVICES

LIGHTING | ENERGY

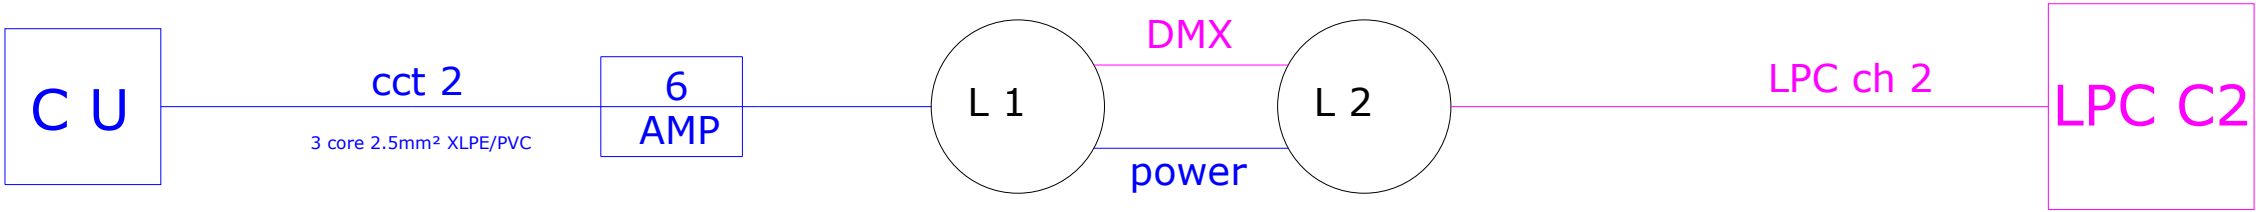

Urbis Sculpline S100 6291 RGBW Diffuser P25 striated 40 Oslon SSL 150 350mA 346982, complete with wall mounting kit and embellishment plate. Mounted on adjustable brackets, on wall. 50W connected load at maximum output.

Existing customer service pillar.

Double deck public lighting cabinet with horizontal divide. To house ESN cut out, and isolator in the lower half.

Upper half to house control units, outgoing electrical circuits, and cutouts.

An Urbis Pharos Lighting Playback Controller shall be installed in an IP66 enclosure in the upper section of the cabinet.

An Urbis Cellular Router shall be installed in an IP66 enclosure in hte upper section of the cabinet.

All necessary connections shall be made between the controller and the router.

Ducts and cables to be laid in accordance with Waterford City & County Council specifications and I. S. 10101: Latest version.

9kN draw rope to be provided in each duct.

Excavation can only be undertaken under the supervision of Waterford City & County Council's approved archaeologist.

Be advised that other services may exist that are not shown on this drawing. This drawing should not be taken as definitive or an indication that it is safe to dig.

Drawing title: As Built Electrical Schematic		
Project title: Fáilte Ireland Urban Animation ~ St. Martin's Gate		
Client: Waterford City & County Council		
Project number: 22017	Date: 08/06/2025	Hard copy approved:
Drawing number: 22017 - 2A	Revision: 0	Draw