



© COPYRIGHT RESERVED (Redmond AMS Ltd.)

Urbis Sculpture S100 6291 RGBW Diffuser P25 striated 40 Oslon SSL 150 350mA. 346982. Complete with mounting kit and embellishment plate. Mounted on adjustable bracket below roof line. To be fixed using chemical anchors only. 50W connected load at maximum output.

Urbis Lighting Playback Controller, and Urbis Cellular Router to be installed close to the consumer unit within the building.

Contractor will be required to find appropriate routing for cables within the building.

All cables to be installed, and connections made in accordance with I.S. 10101: Latest version.

Be advised that other services may exist that are not shown on this drawing. This drawing should not be taken as definitive or an indication that it is safe to dig.

Drawing title:
As Built Illumination Layout

Project title:
Fáilte Ireland Urban Animation ~ The Granary

Client:
Waterford City & County Council

Project number: 22018	Date: 08/06/2025	Hard copy approved:
Drawing number: 22018 - 1A	Revision: 0	Drawn by: Patrick Redmond

Read in conjunction with associated lighting calculations


Do not scale from drawing	All dimensions in metres
Document control: TD 09	Version: 1.0

Redmond Analytical Management Services Ltd.
Rosewood House, Mount Seaton, Camolin, Enniscorthy, Co. Wexford. Y21 K8P3
086 2356356 | info@redmondams.ie | www.redmondams.ie

ANALYTICAL MANAGEMENT SERVICES
LIGHTING | ENERGY | DESIGN | SUPPORT

MSLL ~ Society of Light and Lighting

MILP ~ Institution of Lighting Professionals

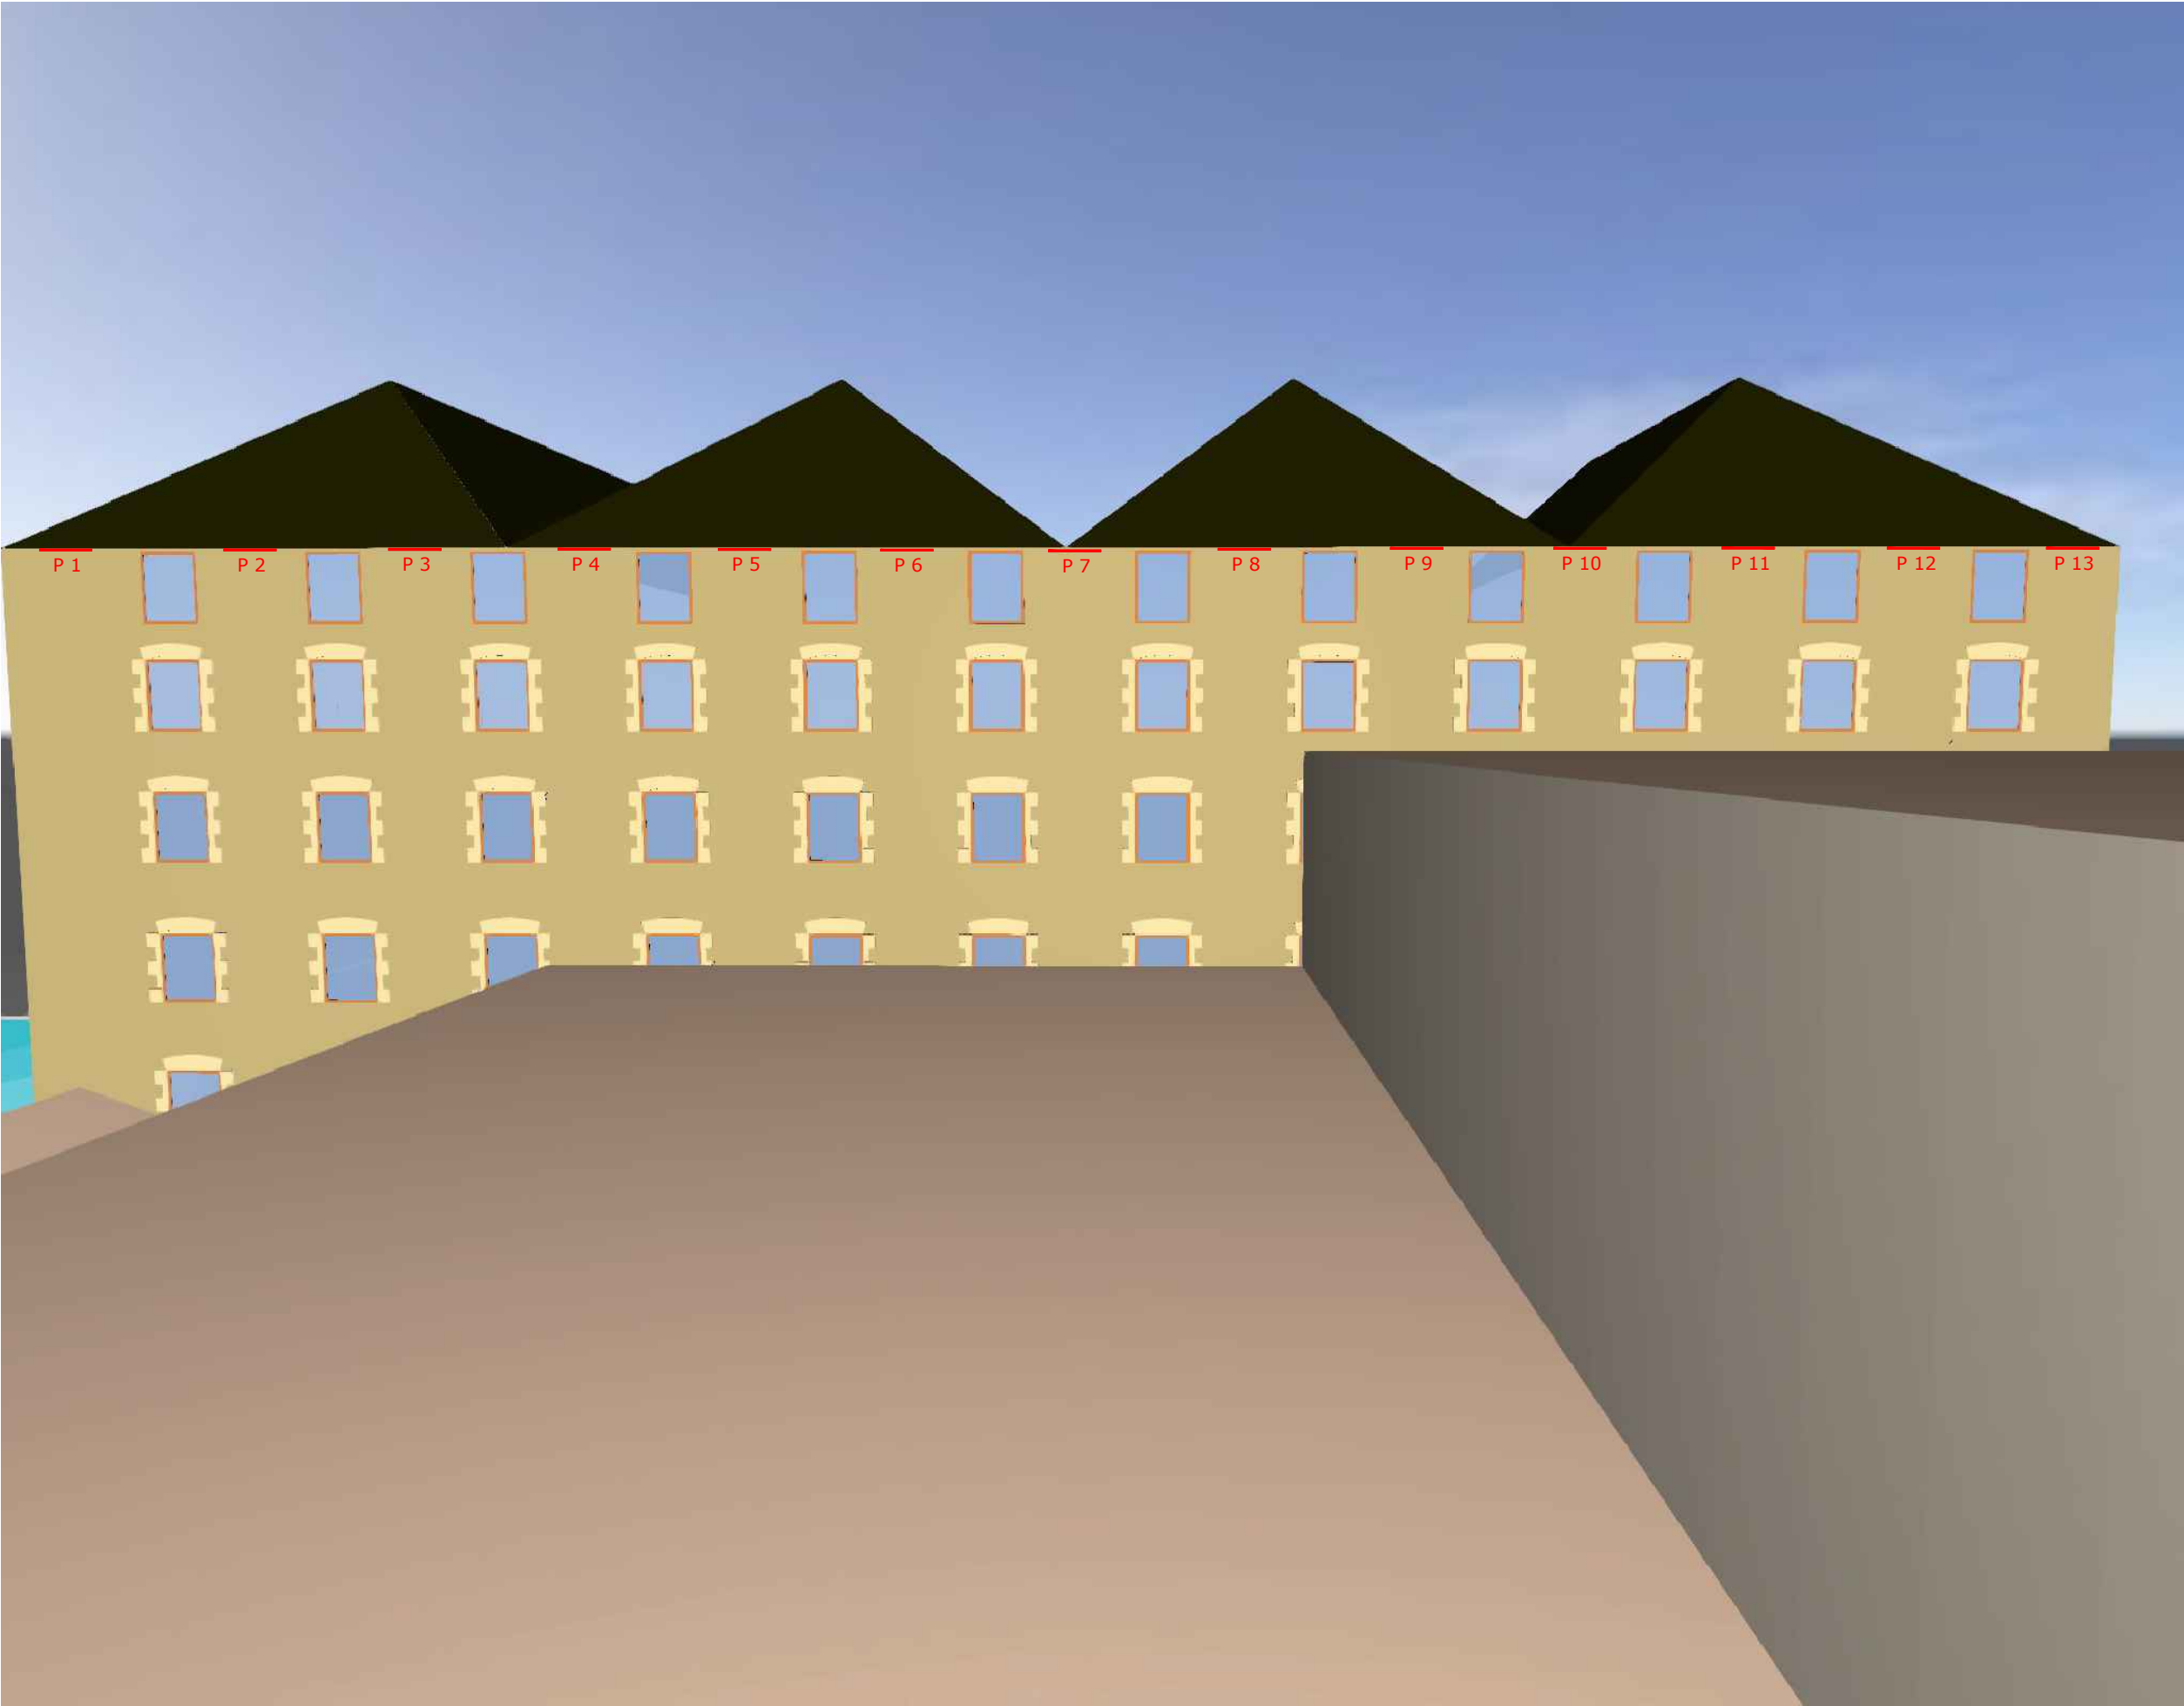

Urbis Sculptline S100 6291 RGBW Diffuser P25 striated 40 Oscon SSL 150 350mA. 346982. Complete with mounting kit and embellishment plate. Mounted on adjustable bracket below roof line. To be fixed using chemical anchors only. 50W connected load at maximum output.

Urbis Lighting Playback Controller, and Urbis Cellular Router to be installed close to the consumer unit within the building.

Contractor will be required to find appropriate routing for cables within the building.

All cables to be installed, and connections made in accordance with I.S. 10101: Latest version.

Be advised that other services may exist that are not shown on this drawing. This drawing should not be taken as definitive or an indication that it is safe to dig.

Drawing title: As Built Illumination Layout		
Project title: Fáilte Ireland Urban Animation ~ The Granary		
Client: Waterford City & County Council		
Project number: 22018	Date: 08/06/2025	Hard copy approved:
Drawing number: 22018 - 2A	Revision: 0	Drawn by: Patrick Redmond
Read in conjunction with associated lighting calculations		
Do not scale from drawing		All dimensions in metres
Document control: TD 09		Version: 1.0
Redmond Analytical Management Services Ltd. Rosewood House, Mount Seaton, Camolin, Enniscorthy, Co. Wexford. Y21 K8P3		
086 2356356	info@redmondams.ie	www.redmondams.ie





© COPYRIGHT RESERVED (Redmond AMS Ltd.)

Urbis Sculptline S100 6291 RGBW Diffuser P25 striated 40 Oscon SSL 150 350mA. 346982. Complete with mounting kit and embellishment plate. Mounted on adjustable bracket below roof line. To be fixed using chemical anchors only. 50W connected load at maximum output.

Urbis Lighting Playback Controller, and Urbis Cellular Router to be installed close to the consumer unit within the building.

Contractor will be required to find appropriate routing for cables within the building.

All cables to be installed, and connections made in accordance with I.S. 10101: Latest version.

Be advised that other services may exist that are not shown on this drawing. This drawing should not be taken as definitive or an indication that it is safe to dig.

Drawing title:
As Built Illumination Layout

Project title:
Fáilte Ireland Urban Animation ~ The Granary

Client:
Waterford City & County Council

Project number: 22018	Date: 08/06/2025	Hard copy approved:
Drawing number: 22018 - 3A	Revision: 0	Drawn by: Patrick Redmond

Read in conjunction with associated lighting calculations

Do not scale from drawing	All dimensions in metres
Document control: TD 09	Version: 1.0

Redmond Analytical Management Services Ltd.
Rosewood House, Mount Seaton, Camolin, Enniscorthy, Co. Wexford. Y21 K8P3
086 2356356 | info@redmondams.ie | www.redmondams.ie




REDMOND
ANALYTICAL MANAGEMENT SERVICES
LIGHTING | ENERGY | DESIGN | SUPPORT

MSLL ~ Society of Light and Lighting

MILP ~ Institution of Lighting Professionals



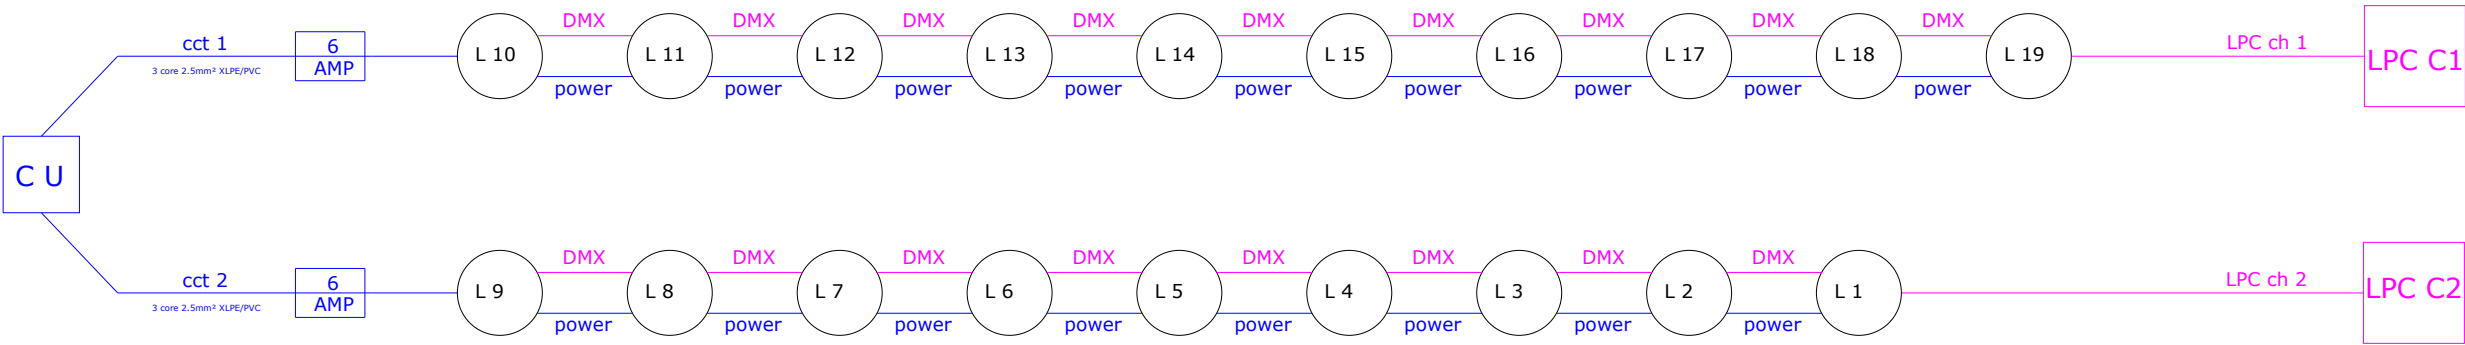

Urbis Sculptline S100 6291 RGBW Diffuser P25 striated 40 Oslon SSL 150 350mA. 346982. Complete with mounting kit and embellishment plate. Mounted on adjustable bracket below roof line. To be fixed using chemical anchors only. 50W connected load at maximum output.

Urbis Lighting Playback Controller, and Urbis Cellular Router to be installed close to the consumer unit within the building.

Contractor will be required to find appropriate routing for cables within the building.

All cables to be installed, and connections made in accordance with I.S. 10101: Latest version.

Be advised that other services may exist that are not shown on this drawing. This drawing should not be taken as definitive or an indication that it is safe to dig.

Drawing title: As Built Electrical Schematic		
Project title: Fáilte Ireland Urban Animation ~ The Granary		
Client: Waterford City & County Council		
Project number: 22018	Date: 08/06/2025	Hard copy approved:
Drawing number: 22018 - 4A	Revision: 0	Drawn by: Patrick Redmond
Read in conjunction with associated lighting calculations		
Do not scale from drawing	All dimensions in metres	
Document control: TD 09	Version: 1.0	
Redmond Analytical Management Services Ltd. Rosewood House, Mount Seaton, Camolin, Enniscorthy, Co. Wexford. Y21 K8		
086 2356356	info@redmondams.ie	www.redmondams.ie



MSLL ~ Society of Light and Lighting

MILP ~ Institution of Lighting Professionals

