


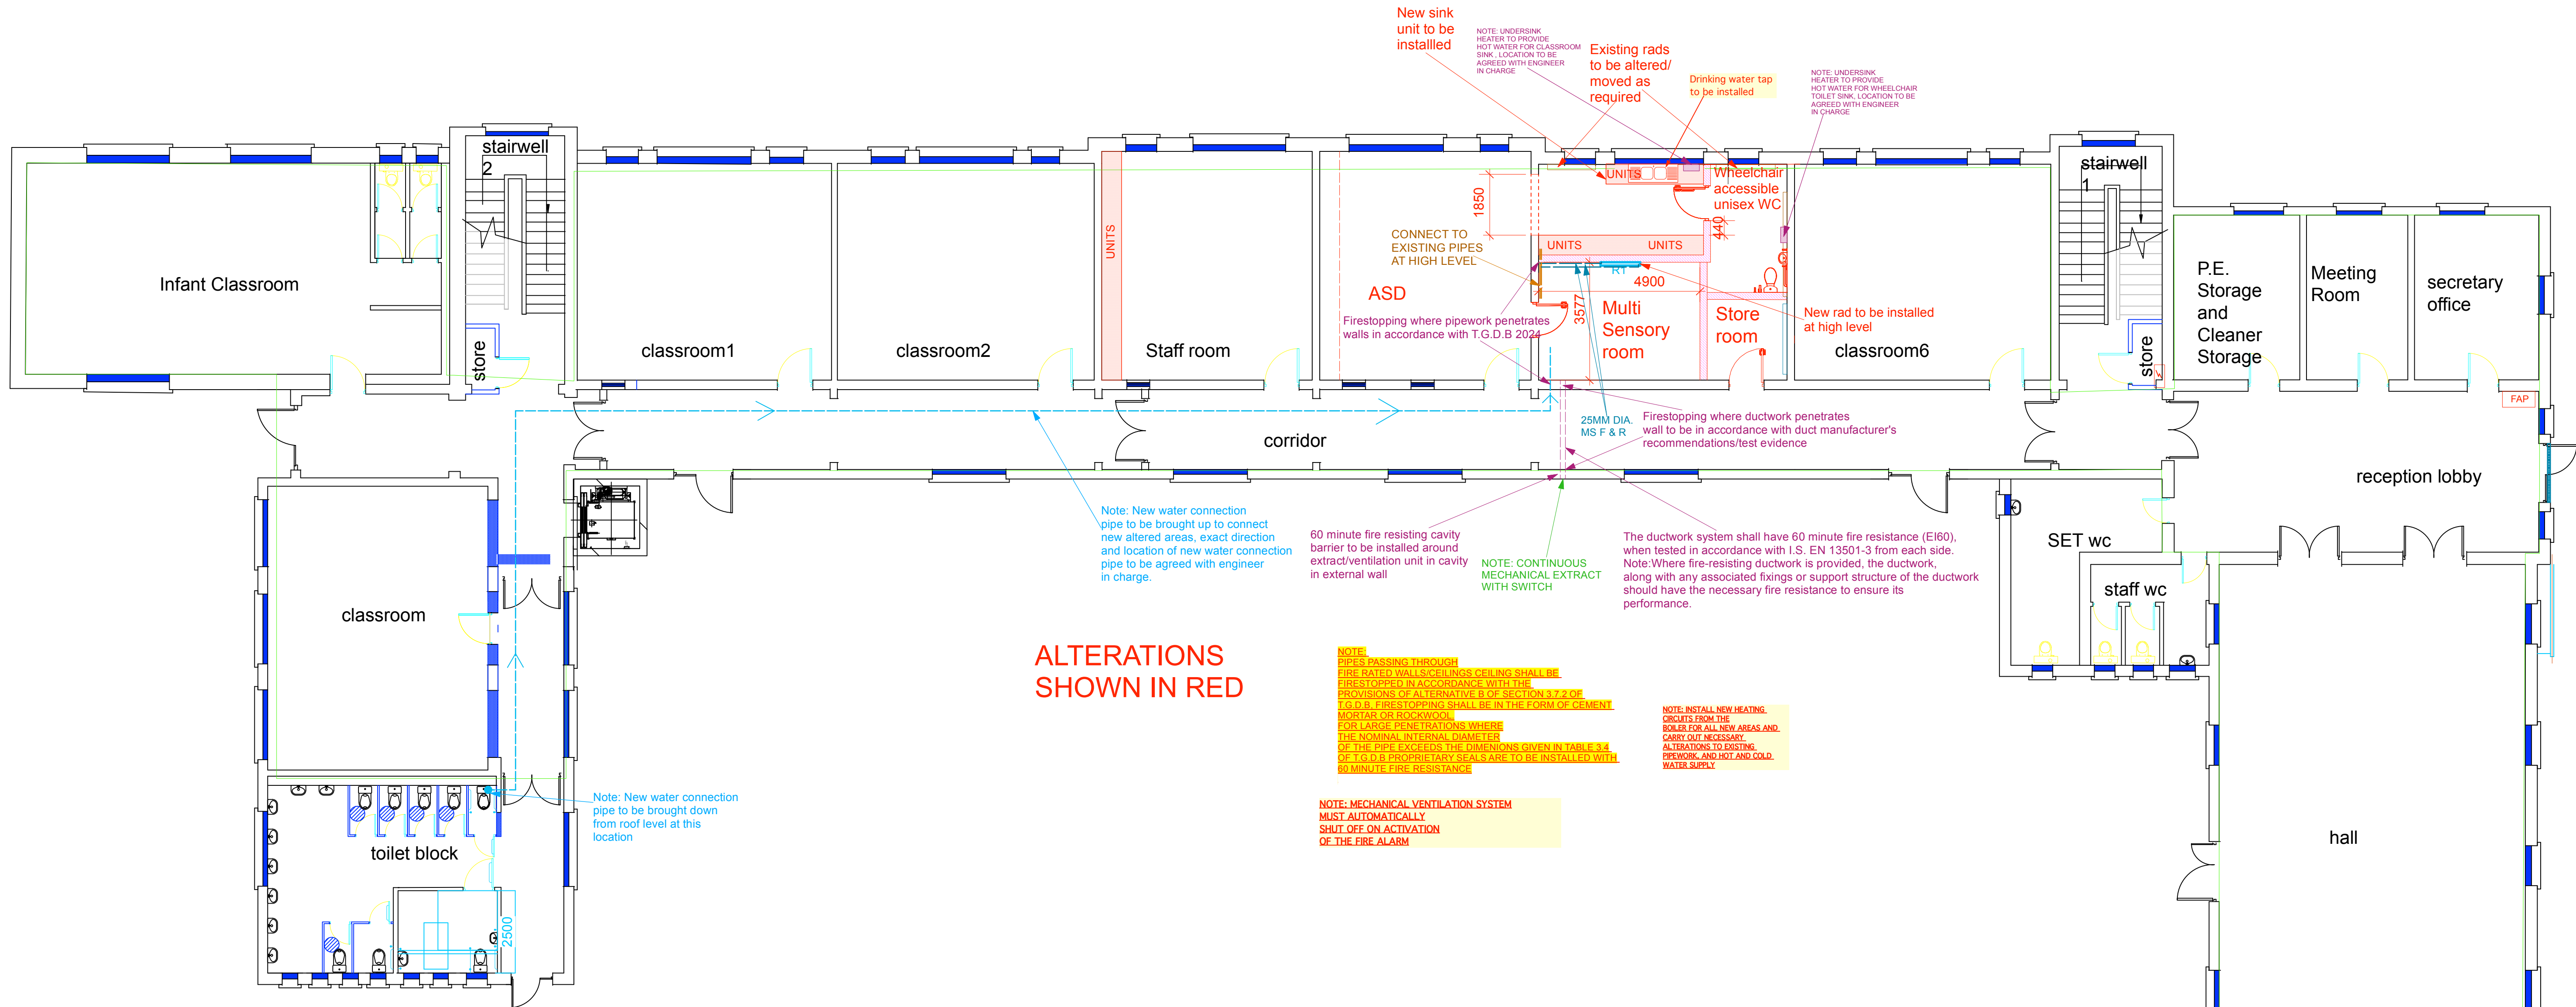

PROPOSED GROUND FLOOR PLAN

Rad Ref.	Range	Type	Heat output (kW)	Size (H x L)
R1	Multi Sensory room	Myson LST SUPER	4019	1022 x 1200

Project Title:

Alterations at Scoil Ailbhe

Drawing Ref. No.:

789424_PS_004

Title:

MECHANICAL MARKUP

Ref. no.

789424

Client:

Scoil Ailbhe, Thurles, Co. Tipperary

Scale: 1-100@A1

Date: 17-7-26

Drawn: D.B.

Checked: P.J.N.

Patrick J. Newell, B.E.,Ph.D.,C.Eng.,Eur.Ing., Oaklands, Headford, Co. Galway.
Phone: 093 35641
Fax.: 093 35050
E-mail: info@newelleng.ie
Website: www.newelleng.ie

All works to comply with Current Irish Building Regulations, Technical Guidance Documents and accompanying details. All work to be in compliance with all relevant Irish, European, British and International Standards.

Use Figured Dimensions only. Do not scale from Drawing.

Any discrepancy between drawings to be notified to Consulting Engineer for clarification.

Compliance with the Building Control (Amendment) Regulations 2014 will be required. The contractor will be required to facilitate the Assigned Certifier as required including providing all requested ancillary certificates and scheduling works to comply with the project Inspection Plan.