


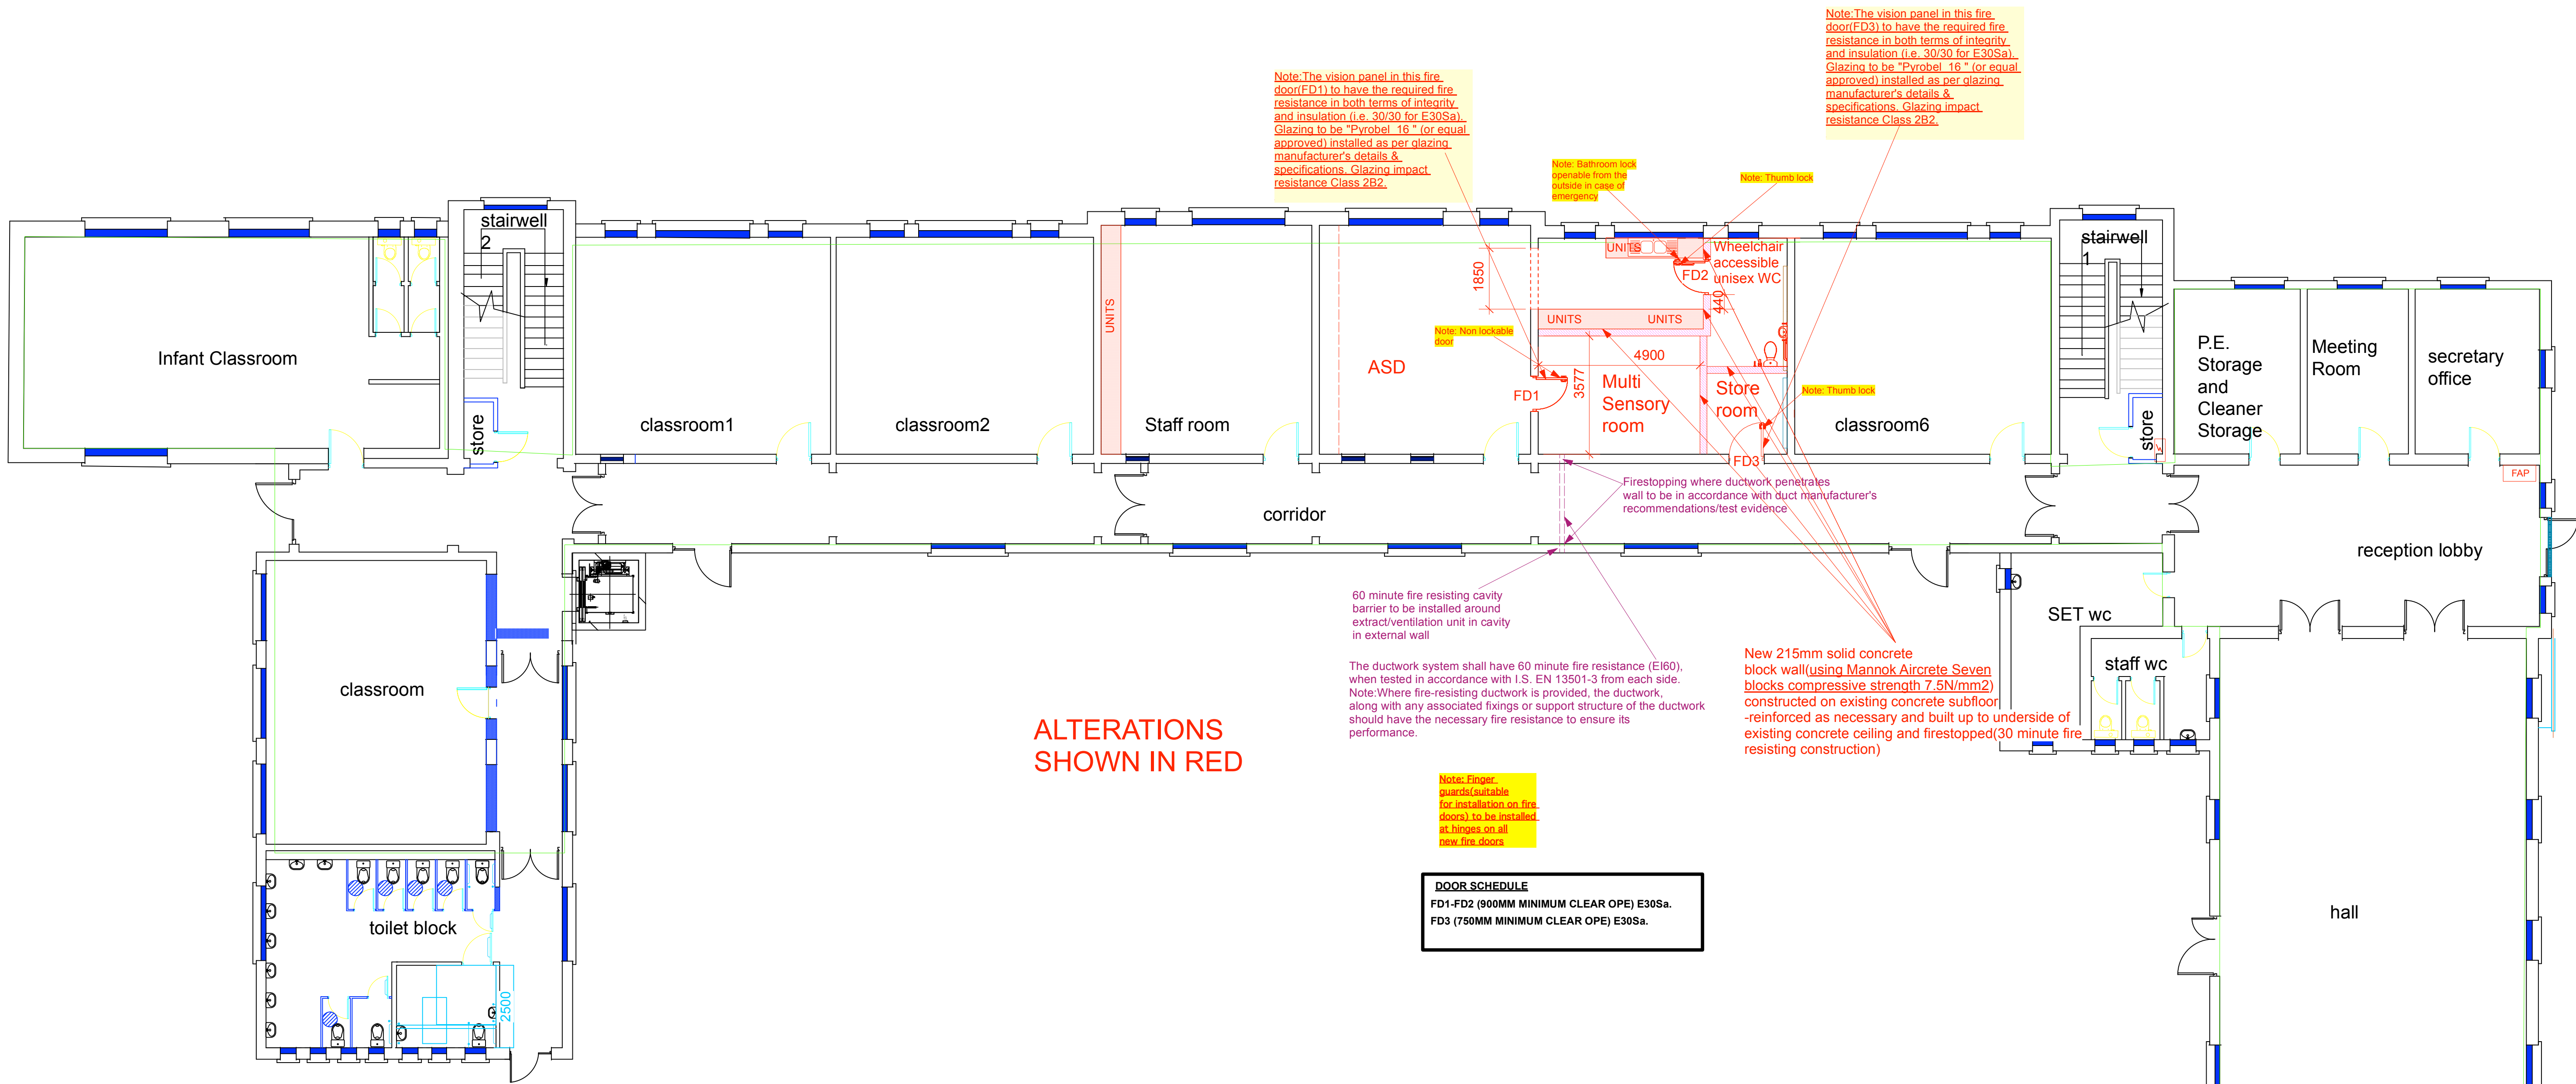

PROPOSED GROUND FLOOR PLAN

Project Title:	Alterations at Scoil Ailbhe
Drawing Ref. No.:	789424_PS_006
Title: FIRE SAFETY MARKUP	Ref. no. 789424
Client: Scoil Ailbhe, Thurles, Co. Tipperary	Scale: 1-100@A1 Date: 17-7-26 Drawn: D.B. Checked: P.J.N.
Patrick J. Newell, B.E., Ph.D., C.Eng., Eur. Ing., Oaklands, Headford, Co. Galway. Phone: 093 35641 Fax.: 093 35050 E-mail: info@newelleng.ie Website: www.newelleng.ie	

All works to comply with Current Irish Building Regulations, Technical Guidance Documents and accompanying details. All work to be in compliance with all relevant Irish, European, British and International Standards.

Use Figured Dimensions only. Do not scale from Drawing.

Any discrepancy between drawings to be notified to Consulting Engineer for clarification.

Compliance with the Building Control (Amendment) Regulations 2014 will be required. The contractor will be required to facilitate the Assigned Certifier as required including providing all requested ancillary certificates and scheduling works to comply with the project Inspection Plan.

Fire safety Signs: Signs shall be provided to indicate exits escape routes, the position of firefighting equipment, Fire alarm, call points. All fire safety signs including Exit signs and markings shall comply with S.I. 132:1995: "Safety Health and Welfare at Work (Signs) Regulations, 1995". Signs in accordance with B.S. 5499:Part 5 2002 should be provided on fire doors.

All fire doors to be signed with minimum 38mm x38mm rigid plastic signs stating "Fire Door Keep Shut" positioned at eye level on both faces of each leaf of the door

Fire Fighting Equipment: Portable Fire Extinguishers to EN3 shall be located within the building in accordance with the equipment of I.S. 291.

30 Min. Fire Resisting Construction
60 Min. Fire Resisting Construction

