


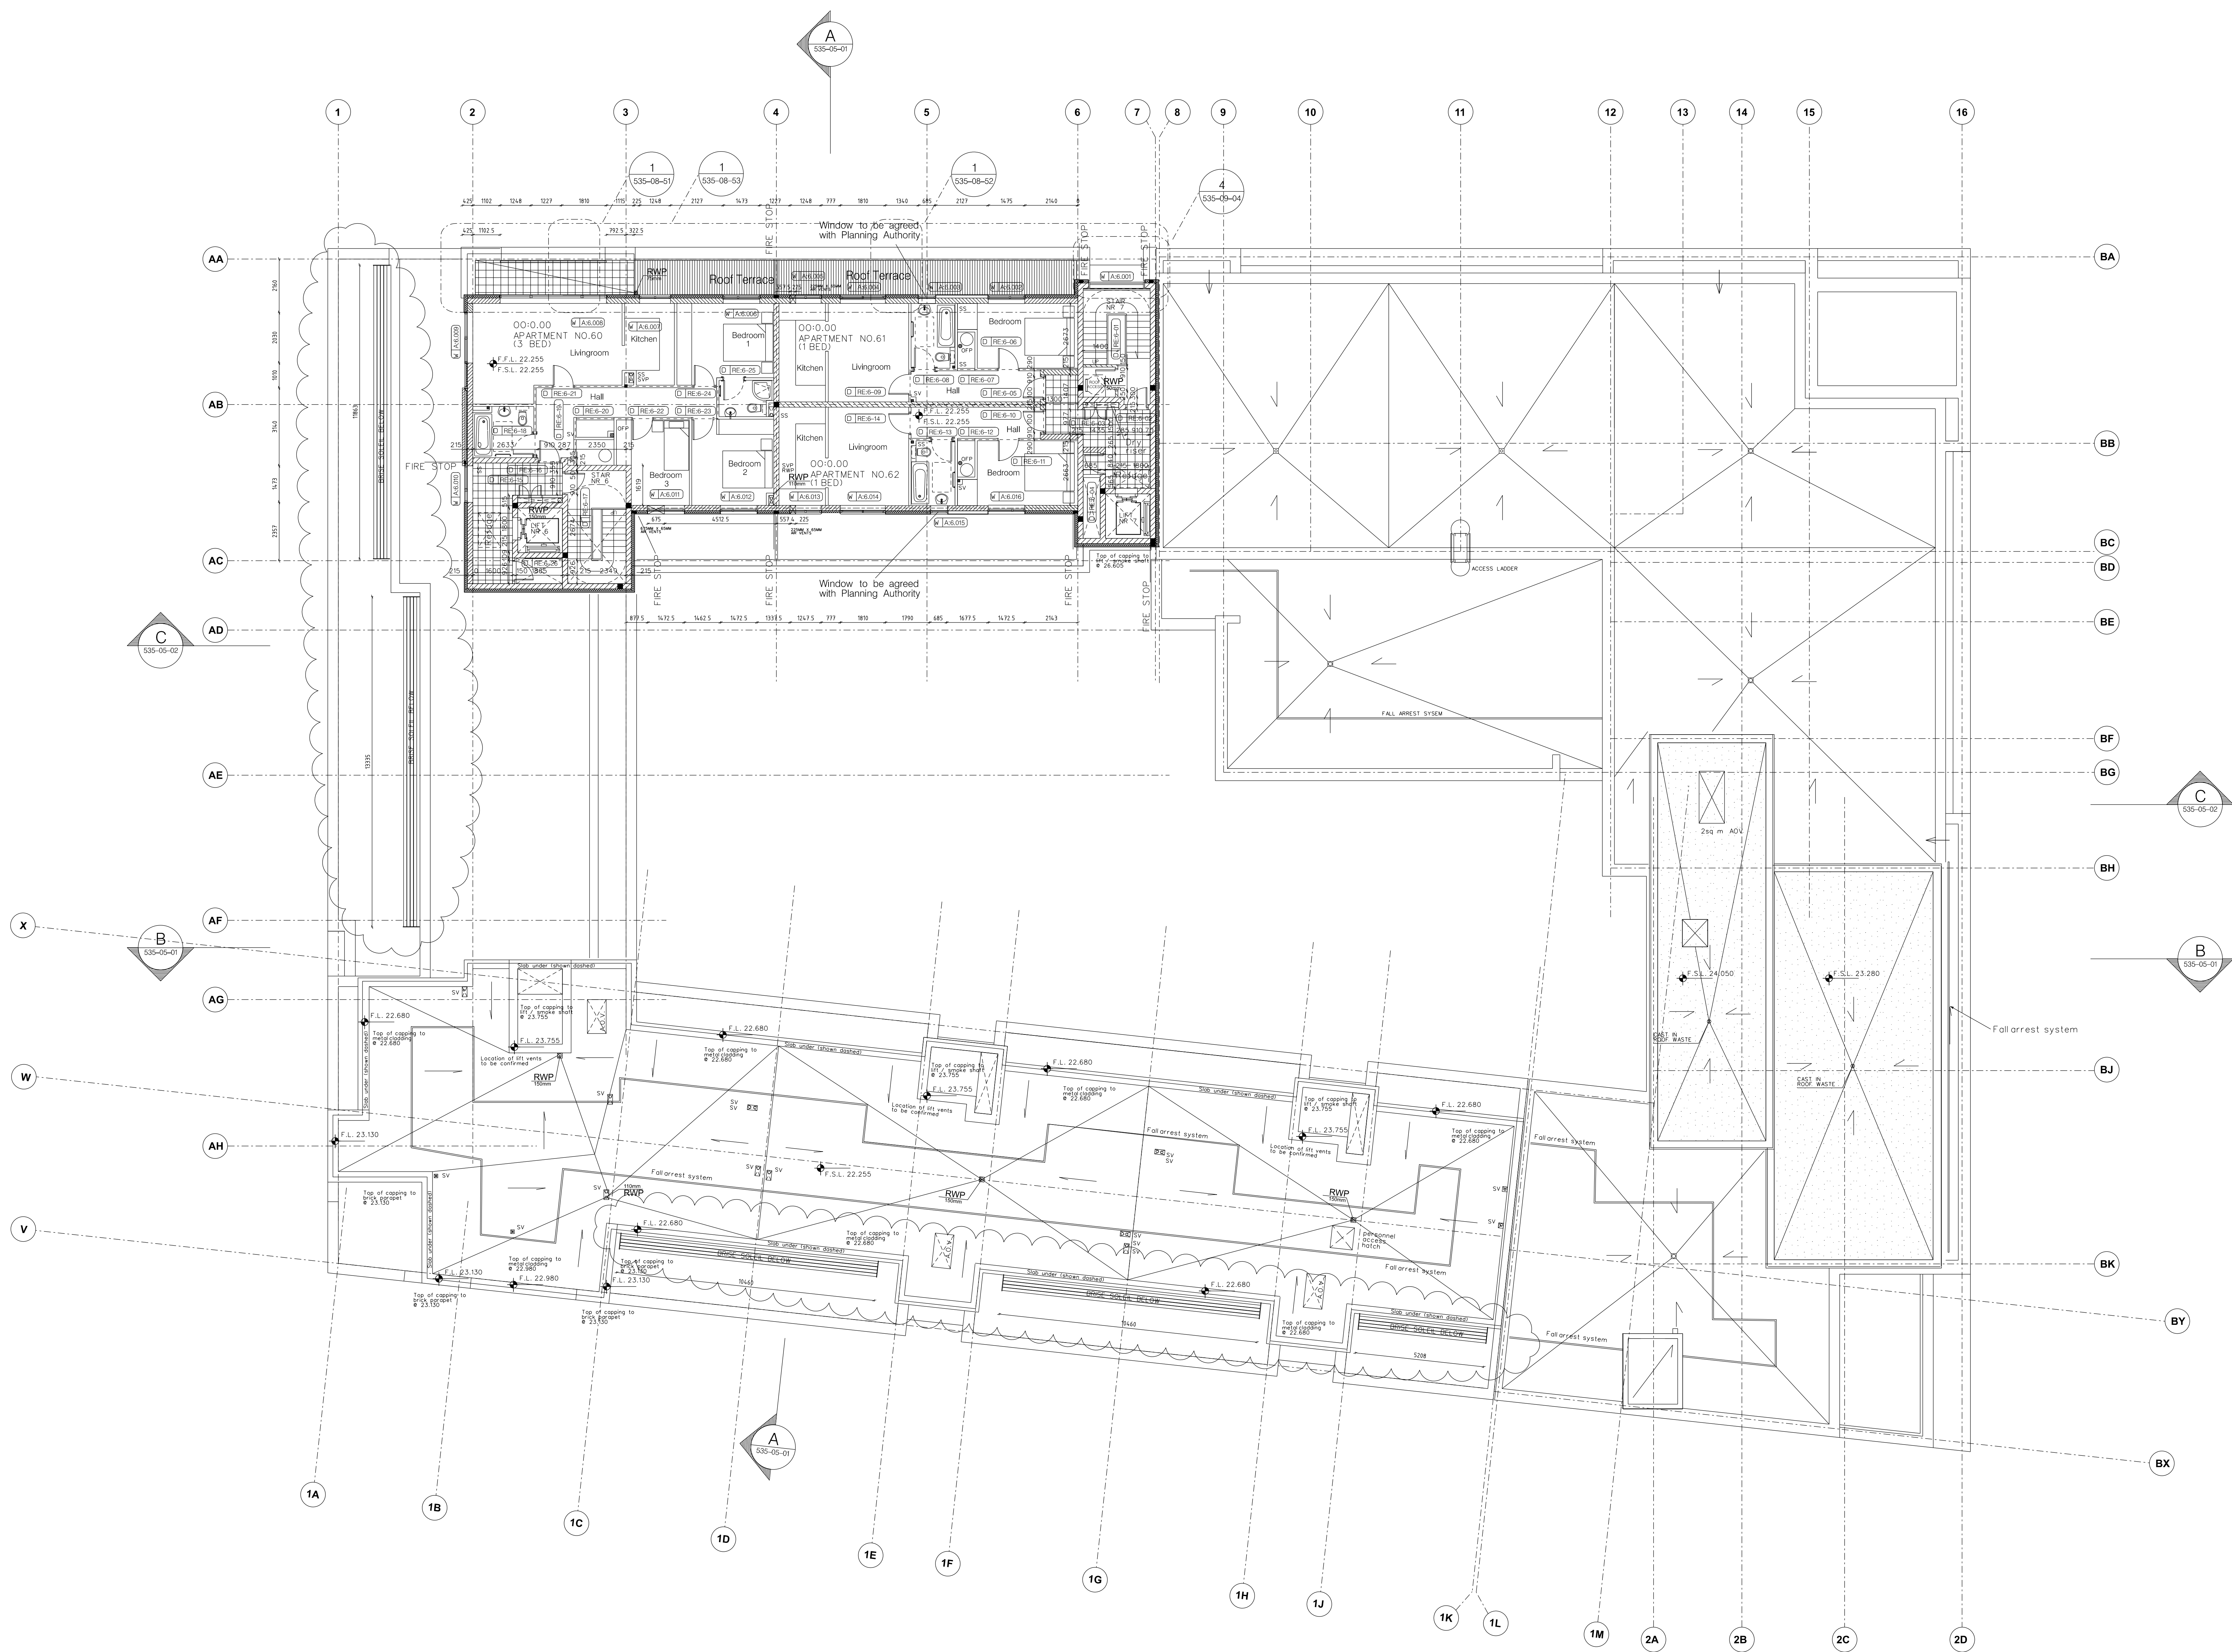

NOTES

- THIS DRAWING IS COPYRIGHT ONLY TO BE USED.
- DO NOT SCALE FROM DRAWING. FIGURED DIMENSIONS ONLY TO BE USED.
- ANY DISCREPANCIES BETWEEN SITE & FIGURED DIMENSIONS SHOULD BE BROUGHT TO THE IMMEDIATE ATTENTION OF THE ARCHITECT.
- REFER TO ENGINEERS DRAWINGS FOR COLUMN & BEAM SIZES AND EXTENT OF RC WORK.
- ALL COMPARTMENT WALLS TO BE BROUGHT UP TO UNDERSIDE OF FLOOR SLABS AND FIRE STOPPED. NO COMBUSTIBLE MATERIALS TO BE BUILT INTO COMPARTMENT WALLS. ALL FLOORS TO BE COMPARTMENT FLOORS. ALL SERVICE DUCTS TO BE DOWN F.R.

LEGEND

- | | | |
|---|-----|--|
| NGTU CONCRETE | RWP | RAIN WATER PIPE 100MM DIA. UNLESS OTHERWISE STATED |
| BLOCKWORK | RW | RAIN WATER |
| FIRE RATED BLOCKWORK | SW | SURFACE WATER |
| RANGED ACCESS FLOOR AREA | SW1 | SURFACE WATER NO 1 |
| WINDOW NUMBER 23 - 1ST FLOOR LEVEL | SW2 | SURFACE WATER NO 2 |
| DOOR NUMBER 11 - 1ST FLOOR LEVEL | SW3 | SURFACE WATER NO 3 |
| GRILLE | SW4 | SURFACE WATER NO 4 |
| RECESSED DOWNLIGHTER | SW5 | SURFACE WATER NO 5 |
| EMERGENCY SMOKE IN ACCORDANCE WITH BS 5446-1:1995 | SW6 | SURFACE WATER NO 6 |
| EMERGENCY LIGHTING TO IS 5217:1989 | SW7 | SURFACE WATER NO 7 |


- | | | |
|--|------|---------------------|
| COMPARTMENT WALL FLOOR ACHIEVING 60 MINUTES | SW8 | SURFACE WATER NO 8 |
| FIRE STOPPING ELEMENTS AND PARTITIONS TO BE EXTENDED UP TO THE ROOF PARTITIONS | SW9 | SURFACE WATER NO 9 |
| ROOF FINISH | SW10 | SURFACE WATER NO 10 |
| ROOF FINISH | SW11 | SURFACE WATER NO 11 |
| ROOF FINISH | SW12 | SURFACE WATER NO 12 |
| ROOF FINISH | SW13 | SURFACE WATER NO 13 |
| ROOF FINISH | SW14 | SURFACE WATER NO 14 |
| ROOF FINISH | SW15 | SURFACE WATER NO 15 |
| ROOF FINISH | SW16 | SURFACE WATER NO 16 |
| ROOF FINISH | SW17 | SURFACE WATER NO 17 |
| ROOF FINISH | SW18 | SURFACE WATER NO 18 |
| ROOF FINISH | SW19 | SURFACE WATER NO 19 |
| ROOF FINISH | SW20 | SURFACE WATER NO 20 |

REV	DATE	DETAILS
L	25/05/05	FINAL DRAWING
K	20/10/04	ISSUED FOR INFORMATION Extent of brise-Soleils indicated
J	26/07/04	ISSUED FOR INFORMATION Revisions made for additional apartments


REV	DATE	DETAILS
I	27/05/04	ISSUED FOR INFORMATION Capping and parapet levels indicated, drainage runs indicated, location and sizes of some RWP's and soil vents modified to apartment building
H	12/03/04	ISSUED FOR INFORMATION PARAPET LEVELS REVISED, ROOF BRAINS REVISED TO SHOW AS-BUILT LOCATIONS
G	19/01/19	ISSUED FOR INFORMATION ROOF FINISH REVISED
F	19/01/19	ISSUED FOR CONSTRUCTION Finished Floor Levels revised

REV	DATE	DETAILS
E	23/10/03	ISSUED FOR CONSTRUCTION Rooflights removed
D	14/10/03	ISSUED FOR CONSTRUCTION Door Schedule
C	22/09/03	ISSUED FOR CONSTRUCTION Window Schedule
B	19/09/03	ISSUED FOR CONSTRUCTION
A	21/08/03	ISSUED FOR CONSTRUCTION Revision A: Additional RWP's & SS's included, revised size of smoke shafts, access shafts to roof level added, fall arrest system added
-	09/07/03	ISSUED FOR CONSTRUCTION

REV	DATE	DETAILS
E	23/10/03	ISSUED FOR CONSTRUCTION Rooflights removed
D	14/10/03	ISSUED FOR CONSTRUCTION Door Schedule
C	22/09/03	ISSUED FOR CONSTRUCTION Window Schedule
B	19/09/03	ISSUED FOR CONSTRUCTION
A	21/08/03	ISSUED FOR CONSTRUCTION Revision A: Additional RWP's & SS's included, revised size of smoke shafts, access shafts to roof level added, fall arrest system added
-	09/07/03	ISSUED FOR CONSTRUCTION

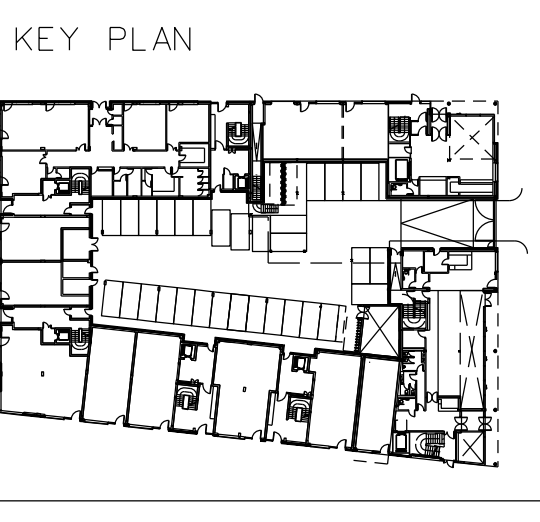

NORTH POINT

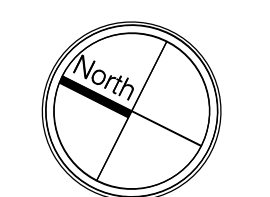

PROJECT: PROPOSED MIXED USE DEVELOPMENT
AT LIBERTY CORNER, DUBLIN 1
TOWN: SIXTH FLOOR PLAN

PROJECT NO: 535
DRAWN BY: LW / MK
CHECKED BY: [Signature]

DATE: OCT. 03
SCALE: 1:100

DATE: OCT. 03
SCALE: 1:100

5 SchoolHouse Lane
Dublin 2
Ireland
Tel: +353 (0) 1 6680400
Fax: +353 (0) 1 6680401
email: info@hkr.ie