
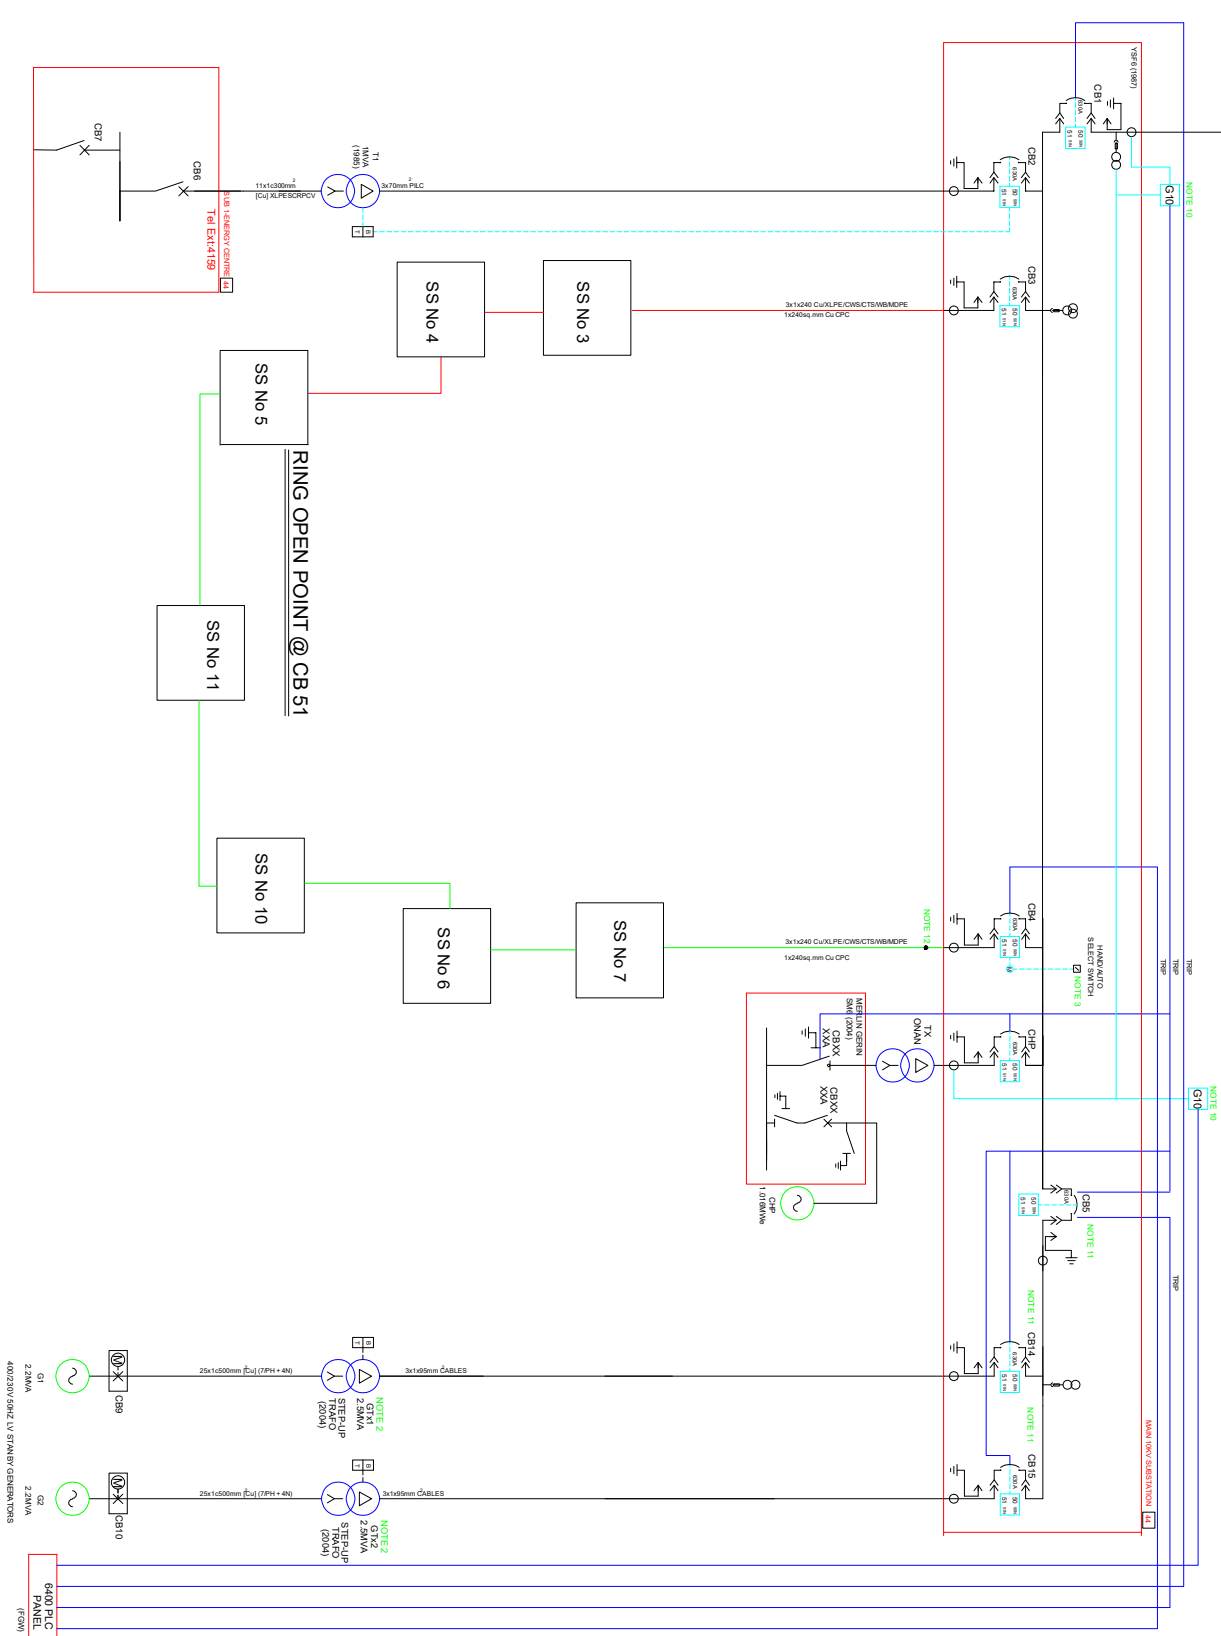


A3 ACAD	1	2	3	4	5	6	7	8	9	10
---------	---	---	---	---	---	---	---	---	---	----

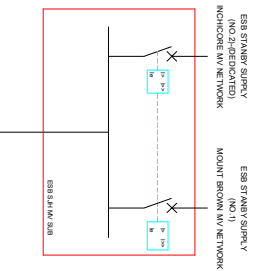

SS No 3 BURNS SUBSTATION
SS No 4 COURTYARD SUBSTATION
SS No 5 PHASE 1H
SS No 6 St KEVIN'S
SS No 7 MORTUARY
SS No 10 PHASE 1H ANNEX
SS No 11 MISA

	D	AS BUILT	15/06/17	
	REV:	DESCRIPTION:	DATE:	APPROVED:
	DRAWN: 00	15/02/12		
MODIFICATIONS:				
ANSI CODES 50/51- OVERCURRENT 50M/51N- EARTH FAULT 27- UNDERVOLTAGE F				
TECHNICAL SERVICES TECHNICAL INFORMATION				
PROJECT: ST JAMES HOSPITAL		CLIENT: ST JAMES HOSPITAL	REF NO.:	P.O. No.:
TITLE: ENERGY CENTRE MAIN SUBSTATION	ENGINEER: DAVID FOLEY	SITE: ST JAMES HOSPITAL	SCALE: 	DRG NO: NS957s0060
All Dimensions in mm	FORMAT: A3	SHEET NO: 00	PAGE: 00	