


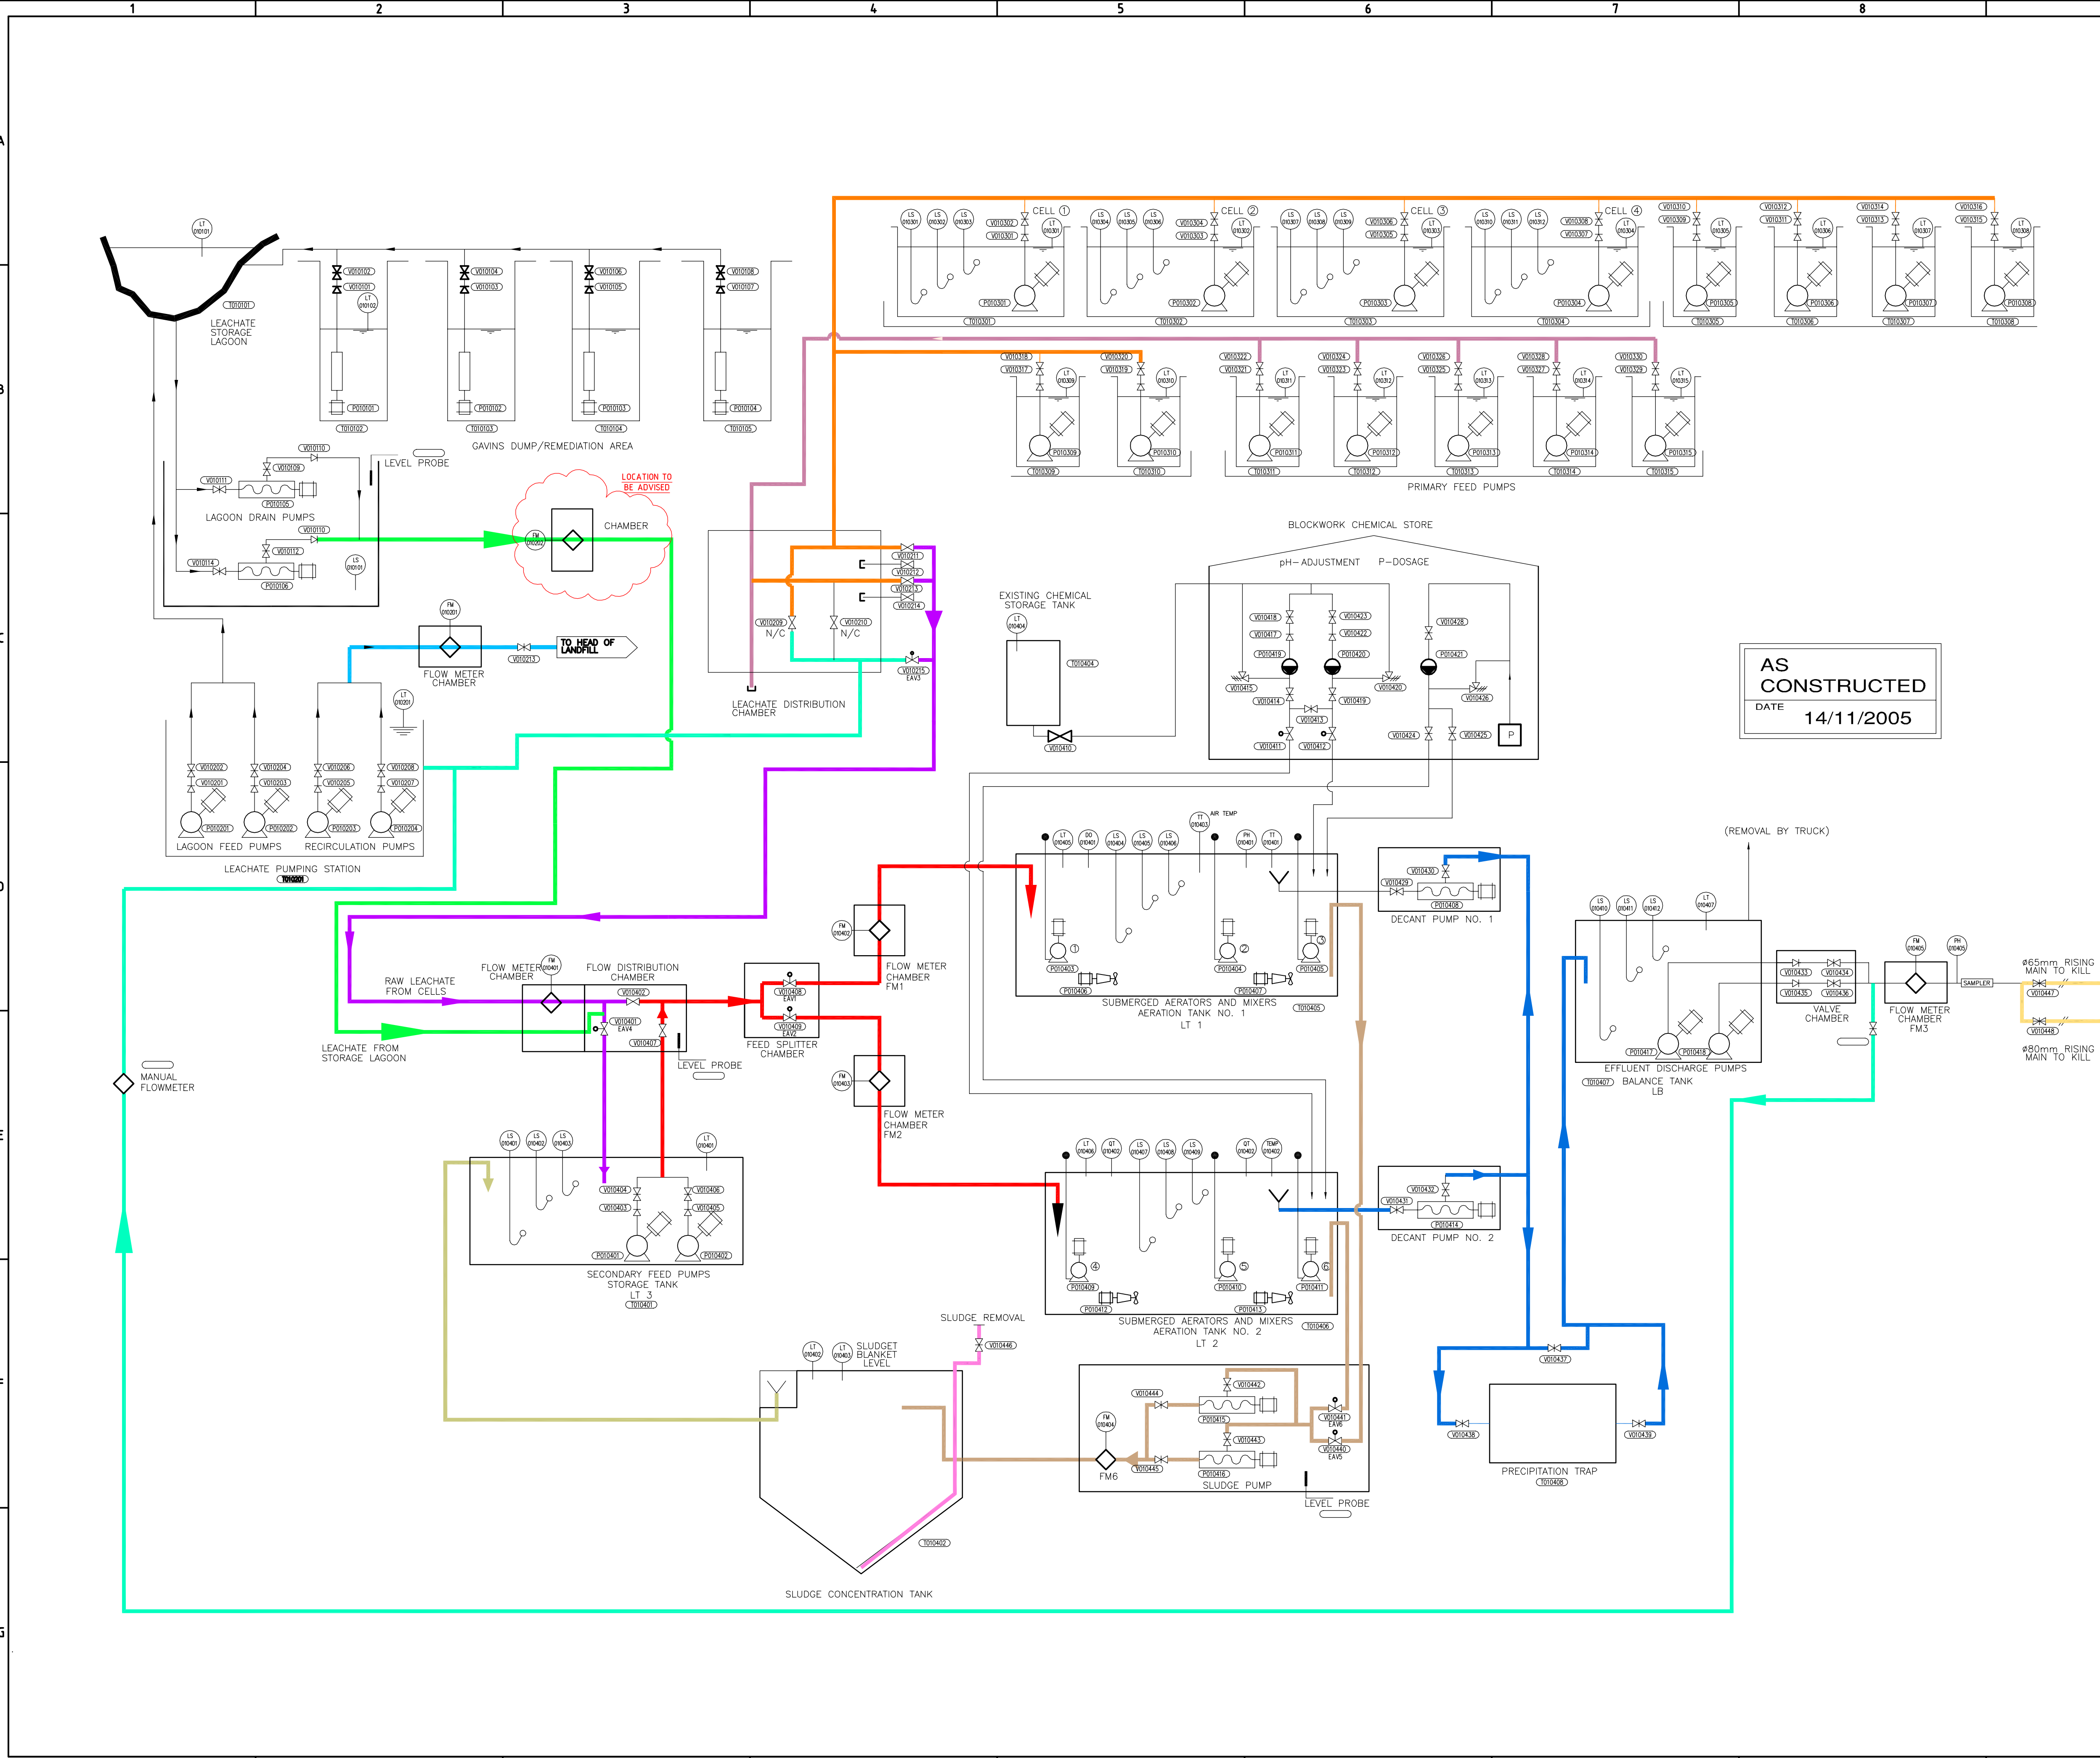

**AS  
CONSTRUCTED**  
DATE 14/11/2005

**FEHILY TIMONEY & Company**  
**AS BUILT**

| Rev. | Drawn | Check | KL | CIC | Rev Origin | Date      | Description           |
|------|-------|-------|----|-----|------------|-----------|-----------------------|
| B    |       |       |    |     | Cork       | 30.8.2007 | ISSUE FOR INFORMATION |

Name of Client  
**ROADBRIDGE LTD.**

Name of Job  
**SBR DESIGN**

Title of Drawing  
**PROCESS  
FLOW DIAGRAM**

|                                                   |                  |
|---------------------------------------------------|------------------|
| Scales Used<br><b>A1-Custom, A3-1:2480.378334</b> |                  |
| Dwg. No.<br><b>2004-130-03-100-022</b>            | Rev.<br><b>B</b> |

**FEHILY TIMONEY & COMPANY**

**CONSULTANTS IN  
ENGINEERING &  
ENVIRONMENTAL  
SCIENCES**

Core House, Pouladuff Rd, Cork, Ireland.  
T: +353-21-4964133, F: +353-21-4964464

Mill House, Ashdown Gate, Navan Rd, Dublin 15, Ireland.  
T: +353-1-6583500, F: +353-1-6583501

W: [www.fehilytimoney.ie](http://www.fehilytimoney.ie), E: [info@ftco.ie](mailto:info@ftco.ie)