


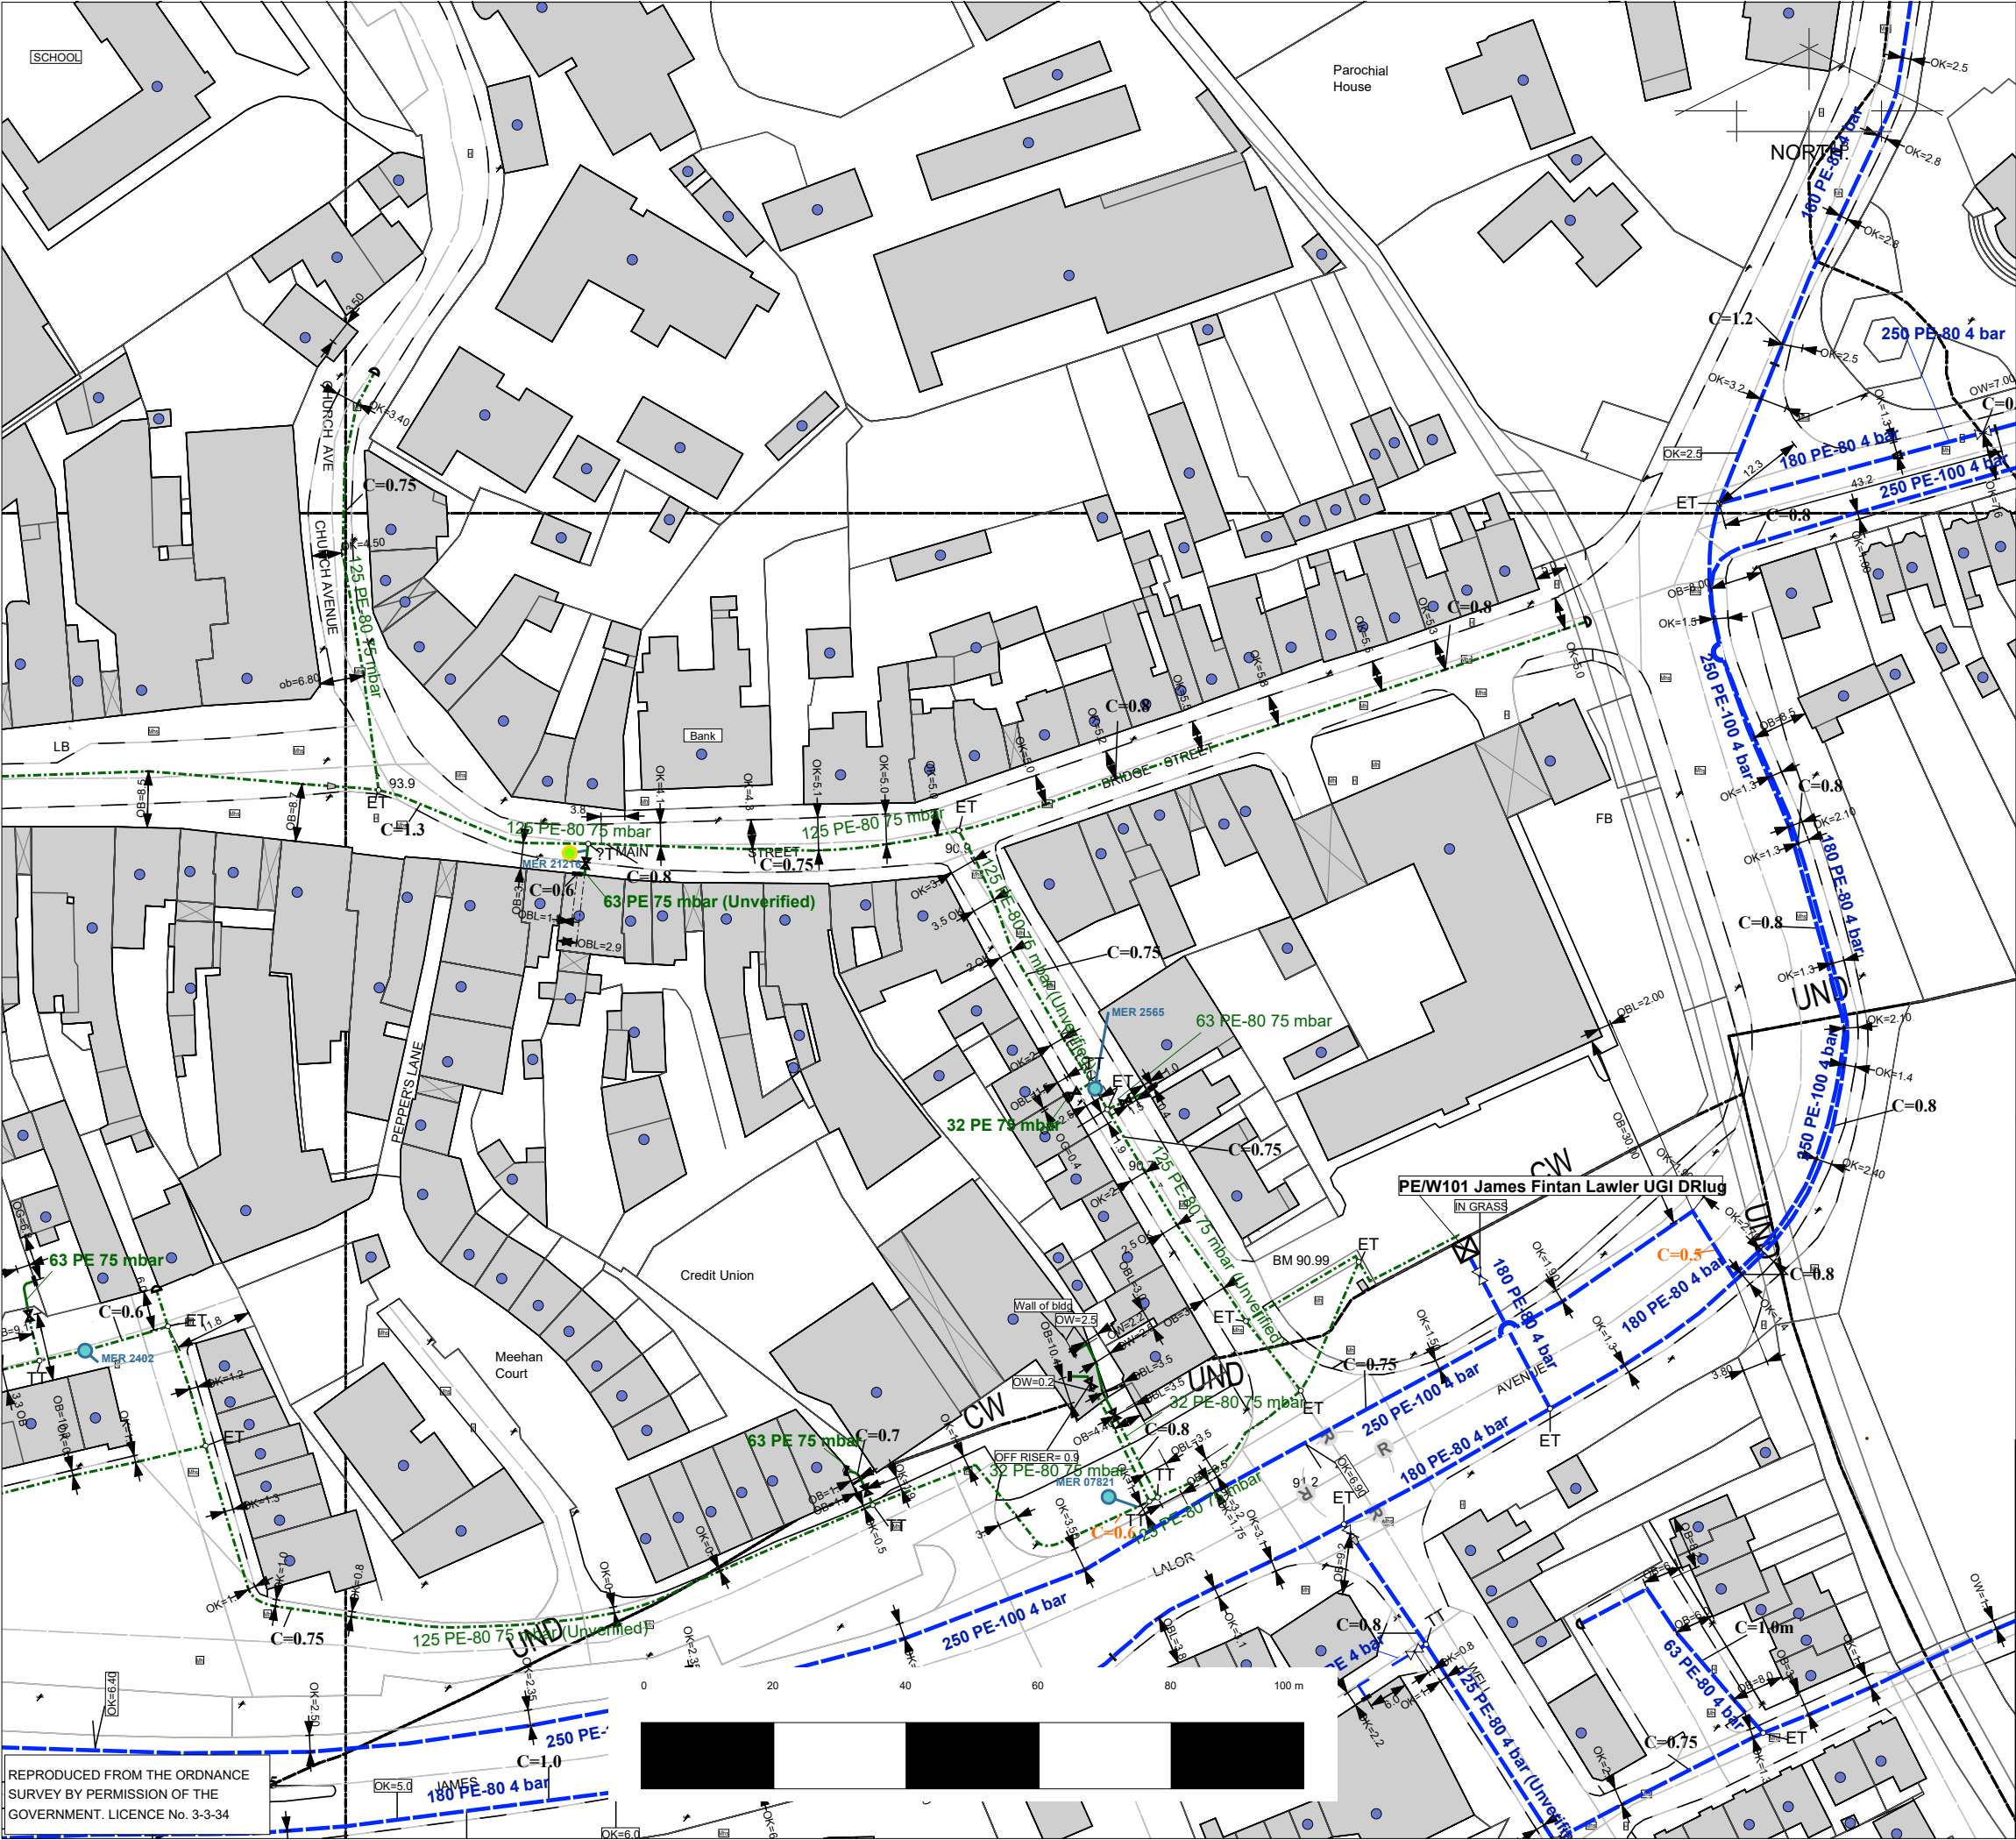

Important Safety Notice:

Damage to gas pipelines can result in serious injury or death. Gas network information is provided as a general guide. The exact location and depth of medium or low pressure distribution gas pipes must be verified on site by carrying out necessary investigations, including, for example, hand digging trial holes along the route of the pipe. Service pipes are not generally shown but their presence should always be anticipated.

High pressure transmission pipelines are shown in red. If a transmission pipeline is identified within 10m of any intended excavations then work must not proceed before GNI has been consulted. The true location and depth of a transmission pipeline must be verified on site by a representative of GNI. Contact can be made through 1800 427 747.

All work in the vicinity of the gas network must be completed in accordance with the current edition of the Health & Safety Authority publication, Code of Practice For Avoiding Danger From Underground Services which is available from the Health and Safety Authority (01 614 7000) or can be downloaded at www.hsa.ie.

Legal Notice:

Gas Networks Ireland (GNI) and its affiliates, accept no responsibility for the accuracy of any information contained in this document including data concerning location and technical designation of the gas distribution and transmission network (the Information). The Information should not be relied on for accurate distance or depth of cover measurements.

Any representations and warranties, express or implied, are excluded to the fullest extent permitted by law. No liability shall be accepted for any loss or damage including, without limitation, direct, indirect or consequential loss, arising out of or in connection with the use or re-use of the Information.

— Aurora Telecom Fibre Optic Cable

— Aurora Telecom Duct

— Aurora Telecom Sub-duct

— Aurora Telecom Inserted Gas Pipe

Contact Aurora Telecom on 1800-427-399 or (01)203-0120.

— Transmission Pipe (High Pressure)

— Transmission Pipe (Construction Issue)

— Distribution Pipe (Medium Pressure)

— Distribution Pipe (Low Pressure)

— Service Pipe (Medium Pressure)

— Service Pipe (Low Pressure)

— Strategic Pipe (Medium Pressure)

— Strategic Pipe (Low Pressure)

— Inserted Pipe (Medium Pressure)

— Inserted Pipe (Low Pressure)

— Distribution Pipe (Abandoned)

— CP Cable

.C=? Cover (depth in meters)

■ CP Ground Bed

■ End Cap

■ Hot Tap

■ Installation

■ Valve

• Mains Verification **

⊠ Pressure Monitor

— Protection (Sleeve)

— Protection (Slabbing)

▭ Reducer

┌ Service Terminator

○ Tee

▭ Transition

** Please contact GNI on 1800-427747 for specific information.

Design Department - DUBLIN



GAS NETWORK INFORMATION

Issue: Laois County Council

Location: County Hotel Portlaoise

Plot Date: 08/08/2025

Contact: P Treacy

Plotted by: KOC

Scale: 1:1000