




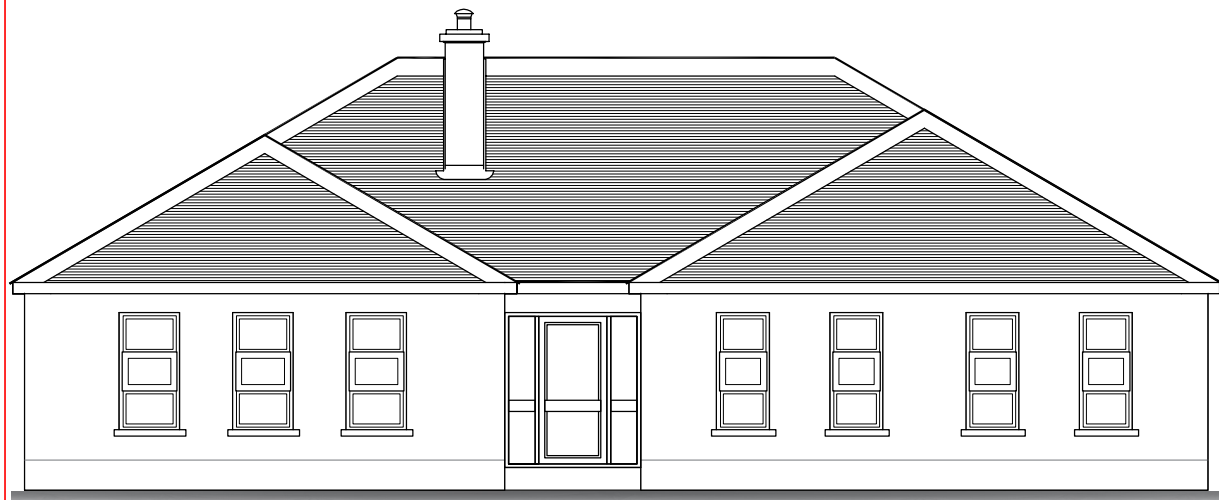


FRONT ELEVATION

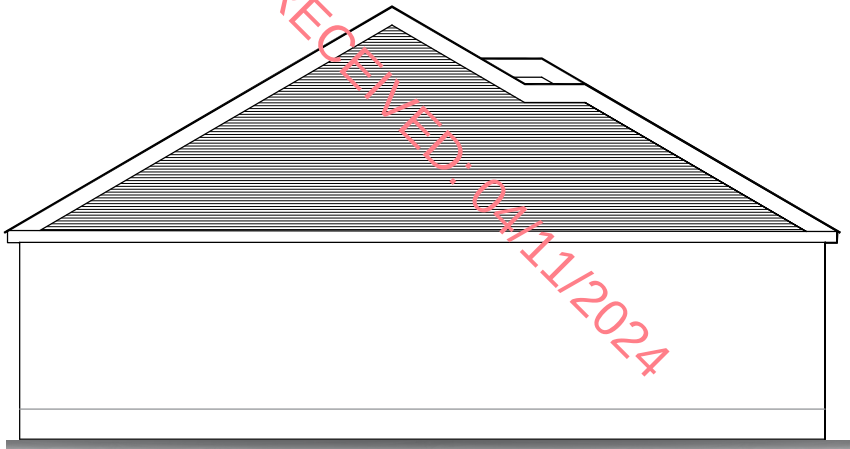


SIDE ELEVATION

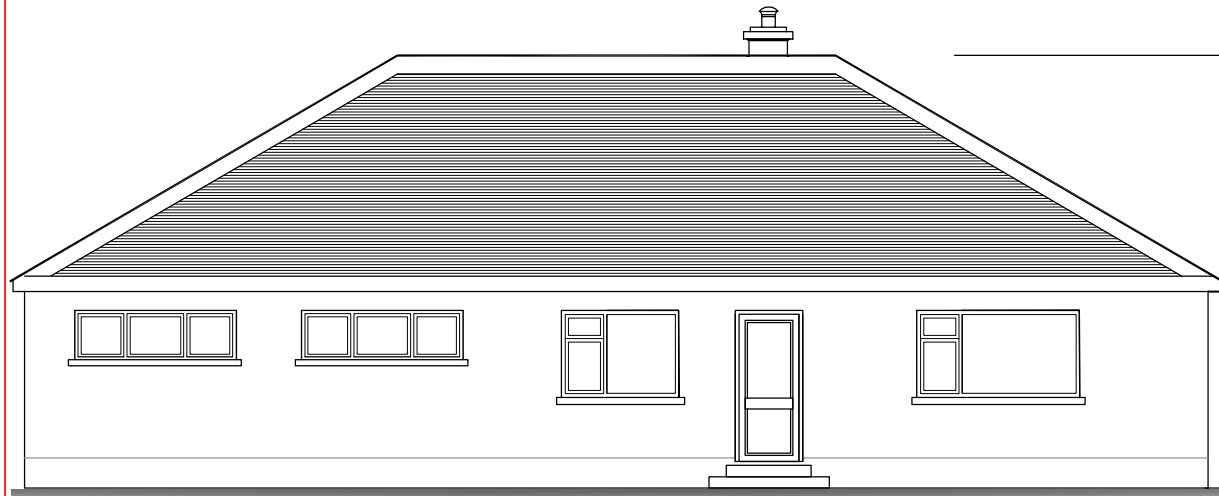

REAR ELEVATION

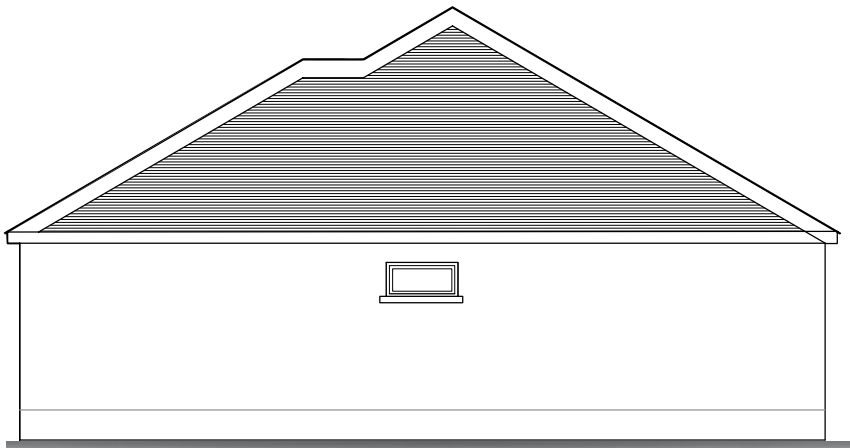


SIDE ELEVATION

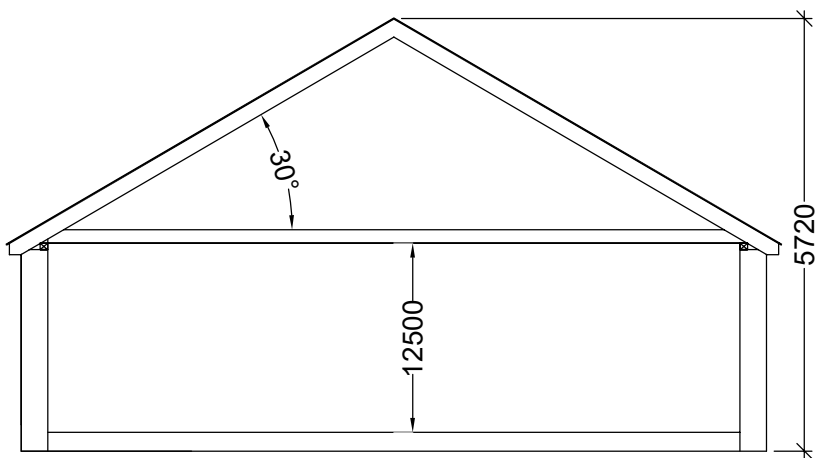

SECTION A-A

Area to be altered / demolished
to be shown in red.

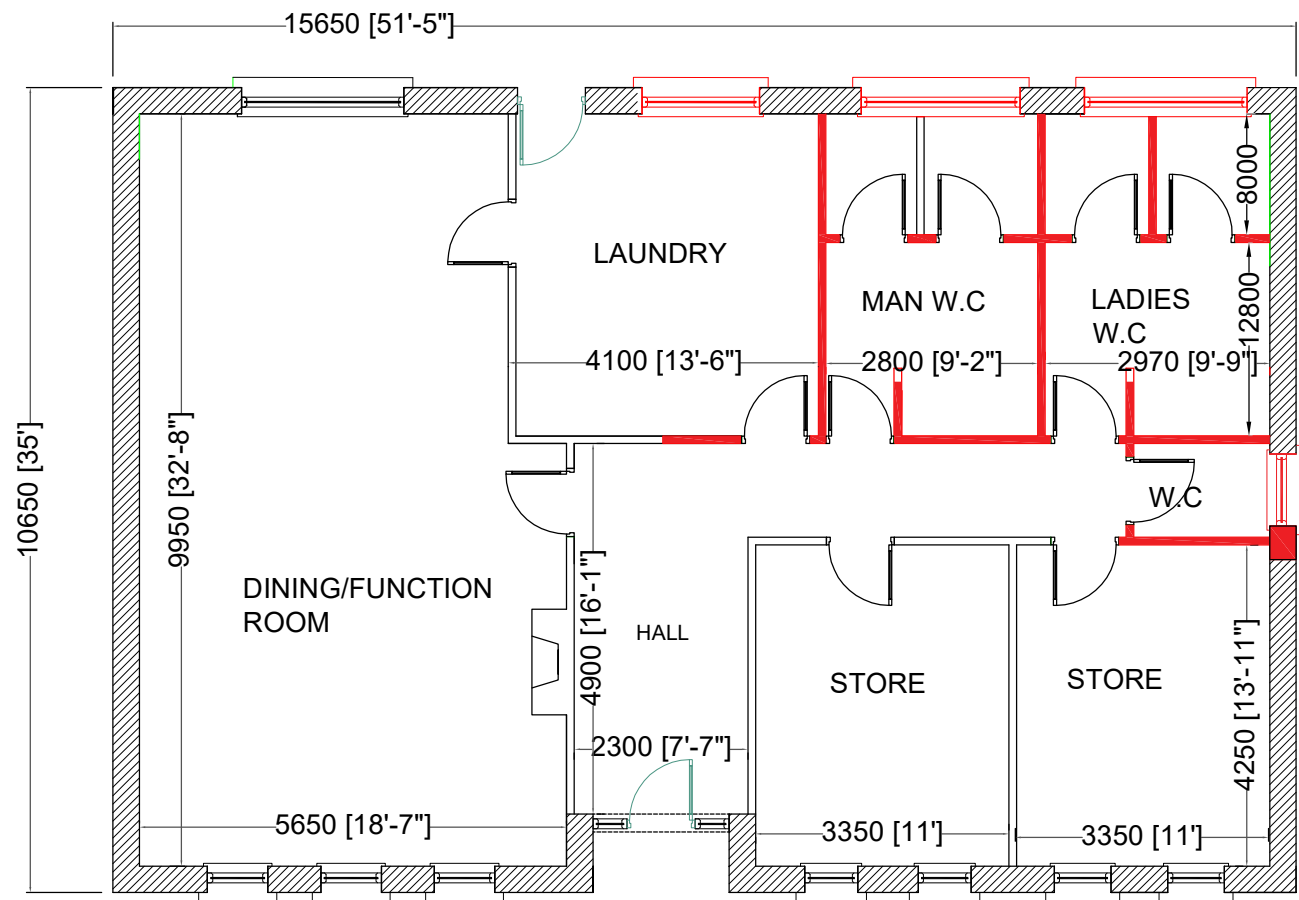

PLAN = 147 M2

All measurements, heights, areas, levels, and structural details to be checked and verified by the contractor, prior to commencement of any works or agreements. Do not scale any drawing. Work to figured dimensions only.

All materials, workmanship, methods of construction to be in accordance with the current Building Regulations in force at time of construction and all local authority conditions of planning etc. Contractors will be fully responsible for all Regulations to comply with, whether or not all notations for same have been implemented on these drawings.

SM

SEAN MALONEY

BUILDING & PLANNING CONSULTANTS
HOUSE DESIGN, PLANNING, ESTIMATING,
PROPERTY LOSS ASSESSING, SITE SURVEYING.

Unit 46,
N17 Business Park,
Tuam,
Co. Galway,
Ireland.
Phone: (093) 26977
Mobile: (087) 719 2820
Fax: (093) 26979

Client	MILLTOWN HOUSING ASSOCIATION LTD	Scale	1:100
Project	COMMUNITY DAY CARE CENTRE ALTERNATION	Date	30/04/2024
Title	PLAN, ELEVATIONS & SECTION	Drawn by:	AB
		Project No.	
		Drawing No.	