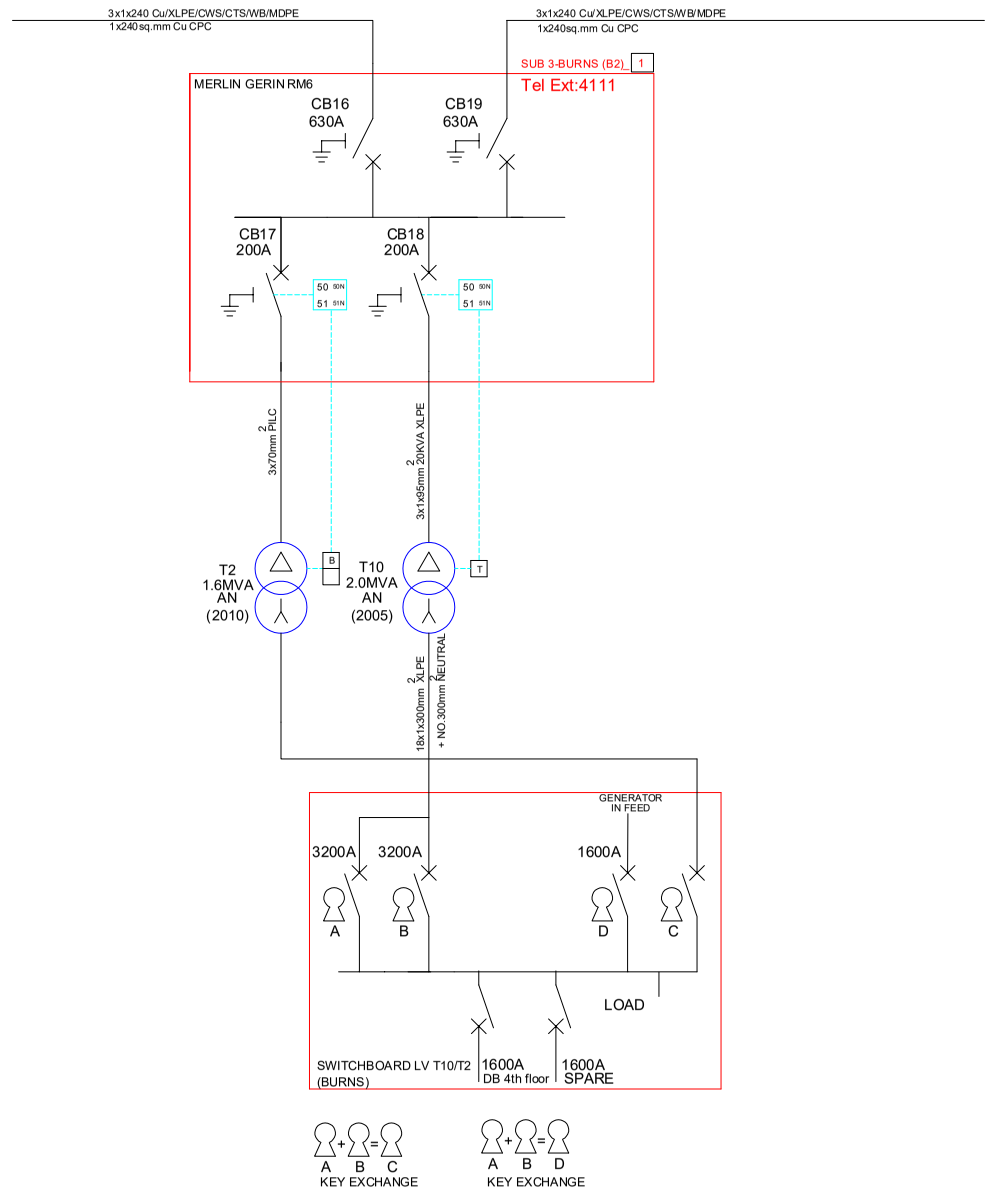


	B	AS BUILT	18/04/24	TSD
DRAWN: OO 15/02/12	REV:	DESCRIPTION:	DATE:	APPROVED:

MODIFICATIONS:Rev J update.

ANSI CODES
- 50/51- OVERCURRENT
- 50N/51N- EARTH FAULT
- 27- UNDERVOLTAGE

FACILITIES MANAGEMENT
ENGINEERING DEPARTMENT

PROJECT: ST JAMES HOSPITAL	CLIENT: ST JAMES HOSPITAL	REF NO.:	P.O. No.:		
TITLE: SS No3 BURNS SUB STATION	ENGINEER: DAVID FOLEY	SCALE: N.T.S.	DRG NO: NS957s0061		
	SITE: ST JAMES HOSPITAL	All Dimensions in mm	FORMAT: A3	SHEET NO: 00	PAGE: 01